
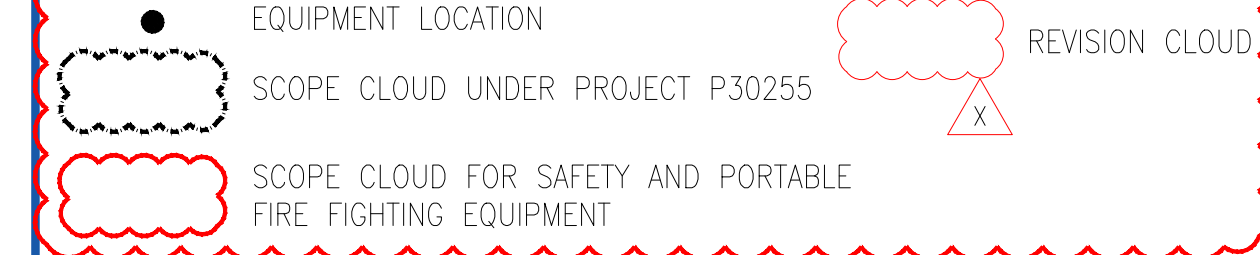



	EPC FOR UPGRADATION OF FACILITIES AT SE FIELD			
	COMMENTS RESOLUTION SHEET (CRS)			
Contract No.	4700022908	Project No.	P30377	Comment Code - 2
Document No.		Transmittal No.	Document Title	☐ 1 Approved – No Comments ☒ 2 Approved Subject to Incorporation of Comments ☐ 3 Revise and Resubmit ☐ 4 Rejected ☐ 5 Retained for Information
P30255-14-16-88-1602	Rev 2	ATC-4700022908-05831-2	EQUIPMENT LAYOUT SAFETY AND PORTABLE FIRE FIGHTING RDS-6 ASAB	

S. No.	PAGE NO./Reference	COMPANY Comments	CONTRACTOR Response	Status / Remarks
HSE COMMENTS				
1	CRS No .6 Page 2	WHY DOCUMEENT CODE OF PROJECT DRAWING IS DIFFERENT THAN THE DOCUMENT CODE USED IN MASTER DRAWING (MASTER DRAWING DOCUMENT CODE IS 87 AND PROJECT DRAWING DOCUMENT CODE IS 88)	Noted, as per COMPANY comment, document code of the layout drawing is changed from 88 to 87 in line with the existing master layout. Hence, the updated layout drawing number is "P30255-14-16-87-1601".	
2	Sheet 1	WHY DOCUMENT CODE FOR PROJECT DRAWING IS DIFFERENT THAN MASTER DRAWING DOCUMENT CODE?	Refer to response above for S No. 1.	
3			As per the COMPANY comment the layout drawing number is changed from "P30255-14-16-88-1602 to P30255-14-16-87-1601", the same is updated in the project EDL.	
ORIGINATOR		REVIEWED BY		APPROVED BY
Name	RK	DV		RPK
Sign				
Date	26.09.2025	26.09.2025		26.09.2025

FORM_ADNOC_Onshore_AD.dwg (REV.1)

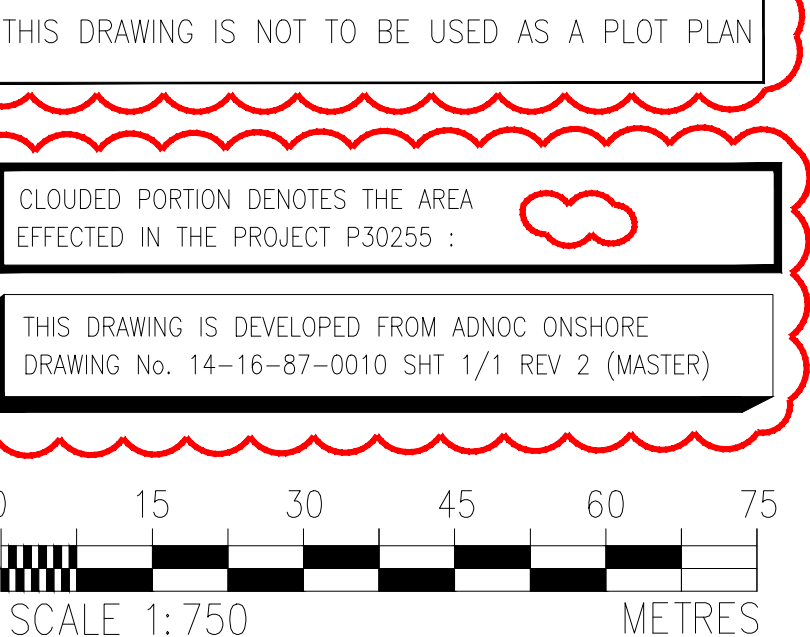

TITLE	DRG. No.
OVERALL PLOT PLAN ASAB RDS-6	14.16.04.0001
FIRE PROTECTION PHILOSOPHY	14.99.91.1840(P14333)
SPECIFICATION FOR SAFETY AND PORTABLE FIRE FIGHTING EQUIPMENT	14.99.84.1607(P14333)
DATA SHEET FOR SAFETY AND PORTABLE FIRE FIGHTING EQUIPMENT	14.99.85.1602(P14333)
SAFETY AND PORTABLE FIRE FIGHTING EQUIPMENT LAYOUT FLARE AREA ASAB RDS-6	14.39.87.0007
ELECTRICAL EQUIPMENT LAYOUT 117.35KV TRANSFORMER YARD & 11KV REACTOR - ASAB RDS 6	P30255-14-16-59-1639
ELECTRICAL EQUIPMENT LAYOUT SUBSTATION-2 (INSTALLATION) RDS-6 : ASAB	P30255-14-16-59-1601-
ELECTRICAL EQUIPMENT LAYOUT 11KV EWDF SUBSTATION (INSTALLATION) ASAB : RDS-6	P30255-14-16-59-1636-
OVERALL PLOT PLAN - RDS - 6	P30255-14-16-04-1602
OVERALL PLOT PLAN RDS-6 ASAB (DEMOLITION)	P30255-14-16-04-1603

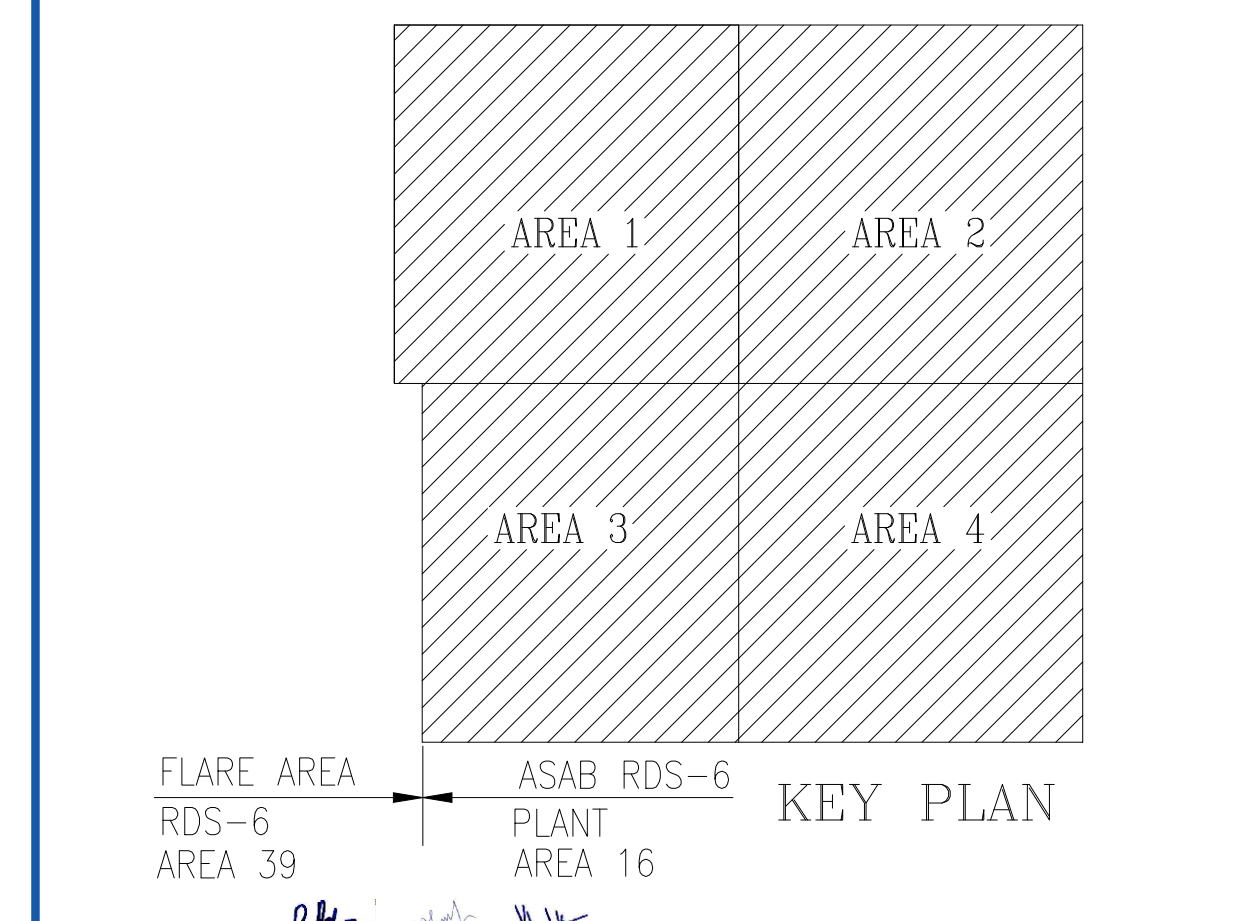



ااديوك
ADNOC

ادنوك البرية

ADNOC Onshore

CONSULTANT /
CONTRACTOR /
~~ENDOR~~



ROBT STONE (ME) LLC
 P.O. Box 9698
 Abu Dhabi, UAE

DRAWING No.

PROJECT: REPLACEMENT OF AGED ELECTRICAL EQUIPMENT
 AT SE FIELD

DRG. TITLE:

EQUIPMENT LAYOUT
 SAFETY AND PORTABLE FIRE FIGHTING
 RDS - 6 : ASAB

DRG. No.	14168716013	1/1
AREA	P/AREA	DOC. CODE
SERIAL No.	REV.	SHT
OF	SHT	

NOTES

1. TWO NOS OF 9kg DRY POWDER FIRE EXTINGUISHER PROVIDED IN A CABINET.
2. FIRE EXTINGUISHER PROVIDED IN A CABINET.
3. FIRE EXTINGUISHERS AND EMERGENCY SAFETY SHOWER LOCATIONS ARE AS PER GENERAL ARRANGEMENT DRAWING (REGULATION) SECTION-A-B,C,D,E,F,G,H,I,J,K,L,M,N,O, ASABR65-6, DWG.NO. 14.16.21.0702 TO 0717.
4. NECESSARY ARRANGEMENT PROVIDED TO SAFETY SHOWER FOR WATER SUPPLY ON/OFF/HEATER ON/OFF, AND CHILLER ON/OFF.
5. FOR FIRE & SAFETY EQUIPMENT SIGN DETAILS REFER DOC. NO.14.11.89.1602P(14333).
6. WATER SUPPLY TAPPED FROM RAW WATER / FRESH WATER PIPE LINE FOR SAFETY SHOWERS.
7. POWER SUPPLY PROVIDED TO SAFETY SHOWERS.
8. ALL EQUIPMENT TAG NUMBERS ON THIS DRAWING ARE PREFIXED BY AREA CODE (14) AND PLANT AREA CODE (16).
9. EXTINGUISHER CABINET IS PROVIDED FOR ALL OUTDOOR LOCATED 9kg DCP / 6kg CO2 IN A BASIS OF 2 EXTINGUISHER PER CABINET.
10. EXTINGUISHER TYPE, DISTRIBUTION, INSTALLATION, AND SUITABILITY TO AMBIENT CONDITIONS SHALL BE AS PER NFPA-10, FIRE AND GAS DETECTION AND FIRE PROTECTION SYSTEM PHASE PROPERTY AREA-14-03-002.
11. ALL EXTINGUISHERS ARE UL LISTED/FM APPROVED/FN 3 APPROVED.
12. OPERATING INSTRUCTIONS, MAINTENANCE INSTRUCTIONS, AND CLASS OF FIRE LABELS SHALL BE PROVIDED AND AFFIXED ON EACH FIRE EXTINGUISHER IN ARABIC AND ENGLISH.
13. EXTINGUISHERS MUST NOT BE PLACED IN AREAS WHERE A FIRE COULD BLOCK ACCESS TO THEM.
14. FINAL LOCATION OF ALL FIREFIGHTING & SAFETY EQUIPMENT IS FINALIZED AT THE SITE.
15. ALL OUTDOOR LOCATED PORTABLE EXTINGUISHERS ARE STORED INSIDE POSTED REINFORCED FIBERGLASS BOXES AND WHEELED EXTINGUISHERS SHALL BE PROVIDED WITH HEAVY DUTY COVER.
16. ~~DELETED~~