

	EPC FOR UPGRADATION OF FACILITIES AT SE FIELD			
	COMMENTS RESOLUTION SHEET (CRS)			
Contract No.	4700022908	Project No.	P30377	Comment Code - 2
Document No.		Transmittal No.	Document Title	☐ 1 Approved – No Comments ☒ 2 Approved Subject to Incorporation of Comments ☐ 3 Revise and Resubmit ☐ 4 Rejected ☐ 5 Retained for Information
P14429-14-16-42-1601	Rev 1	ATC-4700022908-05915	FIRE & GAS SYSTEM CAUSE & EFFECT DIAGRAM FOR RDS-6 CONTROL ROOM BUILDING : ASAB	

S. No.	Reference / Page No.	COMPANY Comments	CONTRACTOR Response	Status / Remarks
1	C&E / SHEET 08	as provided comments i F&G Layouts, clarify the requirement of smoke detection in HVAC as per NFPA 72 and UAE Fire Code.	Noted. As discussed and agreed with COMPANY HSE during the face to face meeting held on 16/10/2025, there is no requirement of smoke detectors in the HVAC ducts as per NFPA 72 standard. Hence, smoke detectors are not required in the HVAC ducts.	
Applicable Comments on P14429-14-11-42-1601 Drawing Discussed During the Face-to-Face Meeting Held on 26-11-2025				
2	Cover Page / Sheet No: 1	Title to be changed to "FIRE AND GAS SYSTEM CAUSE AND EFFECT FOR RDS-6 CONTROL ROOM BUILDING: ASAB - TYPICAL COMMENT."	Noted and updated the title as per COMPANY comment.	
3	Sheet No: 2	Fix outer border thickness in the Cause & Effect diagram, typical for all	Noted and fixed the borders as per COMPANY comment.	
4	Sheet No: 3	The font size to be adjusted / increased.	Noted and updated the font sizes as per COMPANY comment.	
5	Sheet No: 3	Text spacing and alignment in the document to be maintained.	Noted and updated the spacing and alignment entirely as per the COMPANY comment.	
6	Sheet No: 3	The Gas alarm shall be shown separately from Fire alarms	Noted and updated the signals as per the existing philosophy.	OPEN
7	Sheet No: 3	CENTRE ALIGN	Noted and centre aligned the description	
8	Sheet No: 3	All capital letters, alignments	Noted and updated the spacing and alignment entirely as per the COMPANY comment.	

	EPC FOR UPGRADATION OF FACILITIES AT SE FIELD			
	COMMENTS RESOLUTION SHEET (CRS)			
Contract No.	4700022908	Project No.	P30377	Comment Code - 2
Document No.		Transmittal No.	Document Title	☐ 1 Approved – No Comments ☒ 2 Approved Subject to Incorporation of Comments ☐ 3 Revise and Resubmit ☐ 4 Rejected ☐ 5 Retained for Information
P14429-14-16-42-1601	Rev 1	ATC-4700022908-05915	FIRE & GAS SYSTEM CAUSE & EFFECT DIAGRAM FOR RDS-6 CONTROL ROOM BUILDING : ASAB	

S. No.	Reference / Page No.	COMPANY Comments	CONTRACTOR Response	Status / Remarks
9	Sheet No: 3	Red font and red highlight denote changes in the project:	Noted and updated the description as per the COMPANY comment.	
	ORIGINATOR		REVIEWED BY	
Name	DHANUSH KUMAR		DHANASEKAR VEERASAMY	
Sign				
Date	29-11-2025		29-11-2025	
	APPROVED BY			
			RAHUL PRAFULLA KHANDEKAR	
				
			29-11-2025	

THIS C&E WAS NOT DISCUSSED DURING FACE TO FACE MEETING



Project No. P30377

EPC FOR UPGRADATION OF FACILITIES AT SE FIELD

DOCUMENT NO: P14429-14-16-42-1601

FIRE & GAS SYSTEM CAUSE & EFFECT DIAGRAM FOR RDS-6 CONTROL ROOM BUILDING : ASAB


LOCATION : 14-16

REVISIONS						EPC CONTRACTOR: ROBT STONE (ME) L.L.C., Abu Dhabi ROBT STONE										
REV	DATE	BY	CH'D	APP'D	DESCRIPTION											
A	26-05-2025	DV	TH	RPK	ISSUED FOR REVIEW (IFR)	PROJECT TITLE : REPLACEMENT OF SDH NETWORK AND TELECOM UPS AT ASAB / SAHIL				LOCATION		Project No.				
B	17-06-2025	DV	TH	RPK	ISSUED FOR APPROVAL (IFA)					14-16	ASAB RDS - 6	P14429				
C	16-07-2025	DV	TH	RPK	RE-ISSUED FOR APPROVAL (IFA)	DOCUMENT NAME : FIRE & GAS SYSTEM CAUSE & EFFECT DIAGRAM FOR RDS-6 CONTROL ROOM BUILDING : ASAB				REV	2	SHT	1	OF	8	
D	07-08-2025	DV	TH	RPK	RE-ISSUED FOR APPROVAL (IFA)											
1	04-09-2025	DV	TH	RPK	ISSUED FOR CONSTRUCTION (HOLD) (IFC)	DOCUMENT NO : 14-16-42-1601				REV	2	SHT	1	OF	8	
2	29-11-2025	DK	DV	RPK	ISSUED FOR CONSTRUCTION (IFC)											
		B. Dhaher	W. Alkhatib	A. Alkhatib						REV	2	SHT	1	OF	8	

	REPLACEMENT OF SDH NETWORK AND TELECOM UPS AT ASAB / SAHIL	Project No. : P14429	
		Doc. No. : 14-16-42-1601	
	FIRE & GAS SYSTEM CAUSE & EFFECT DIAGRAM FOR RDS-6 CONTROL ROOM BUILDING : ASAB	Revision : 2	
		Date : 29-11-2025	

INDEX	PAGE NO.
COVER SHEET	1
INDEX SHEET	2
FIRE & GAS SYSTEM CAUSE & EFFECT DIAGRAM FOR RDS-6 CONTROL ROOM BUILDING : ASAB	8

INDEX IS INCOMPLETE. CHECK AND UPDATE

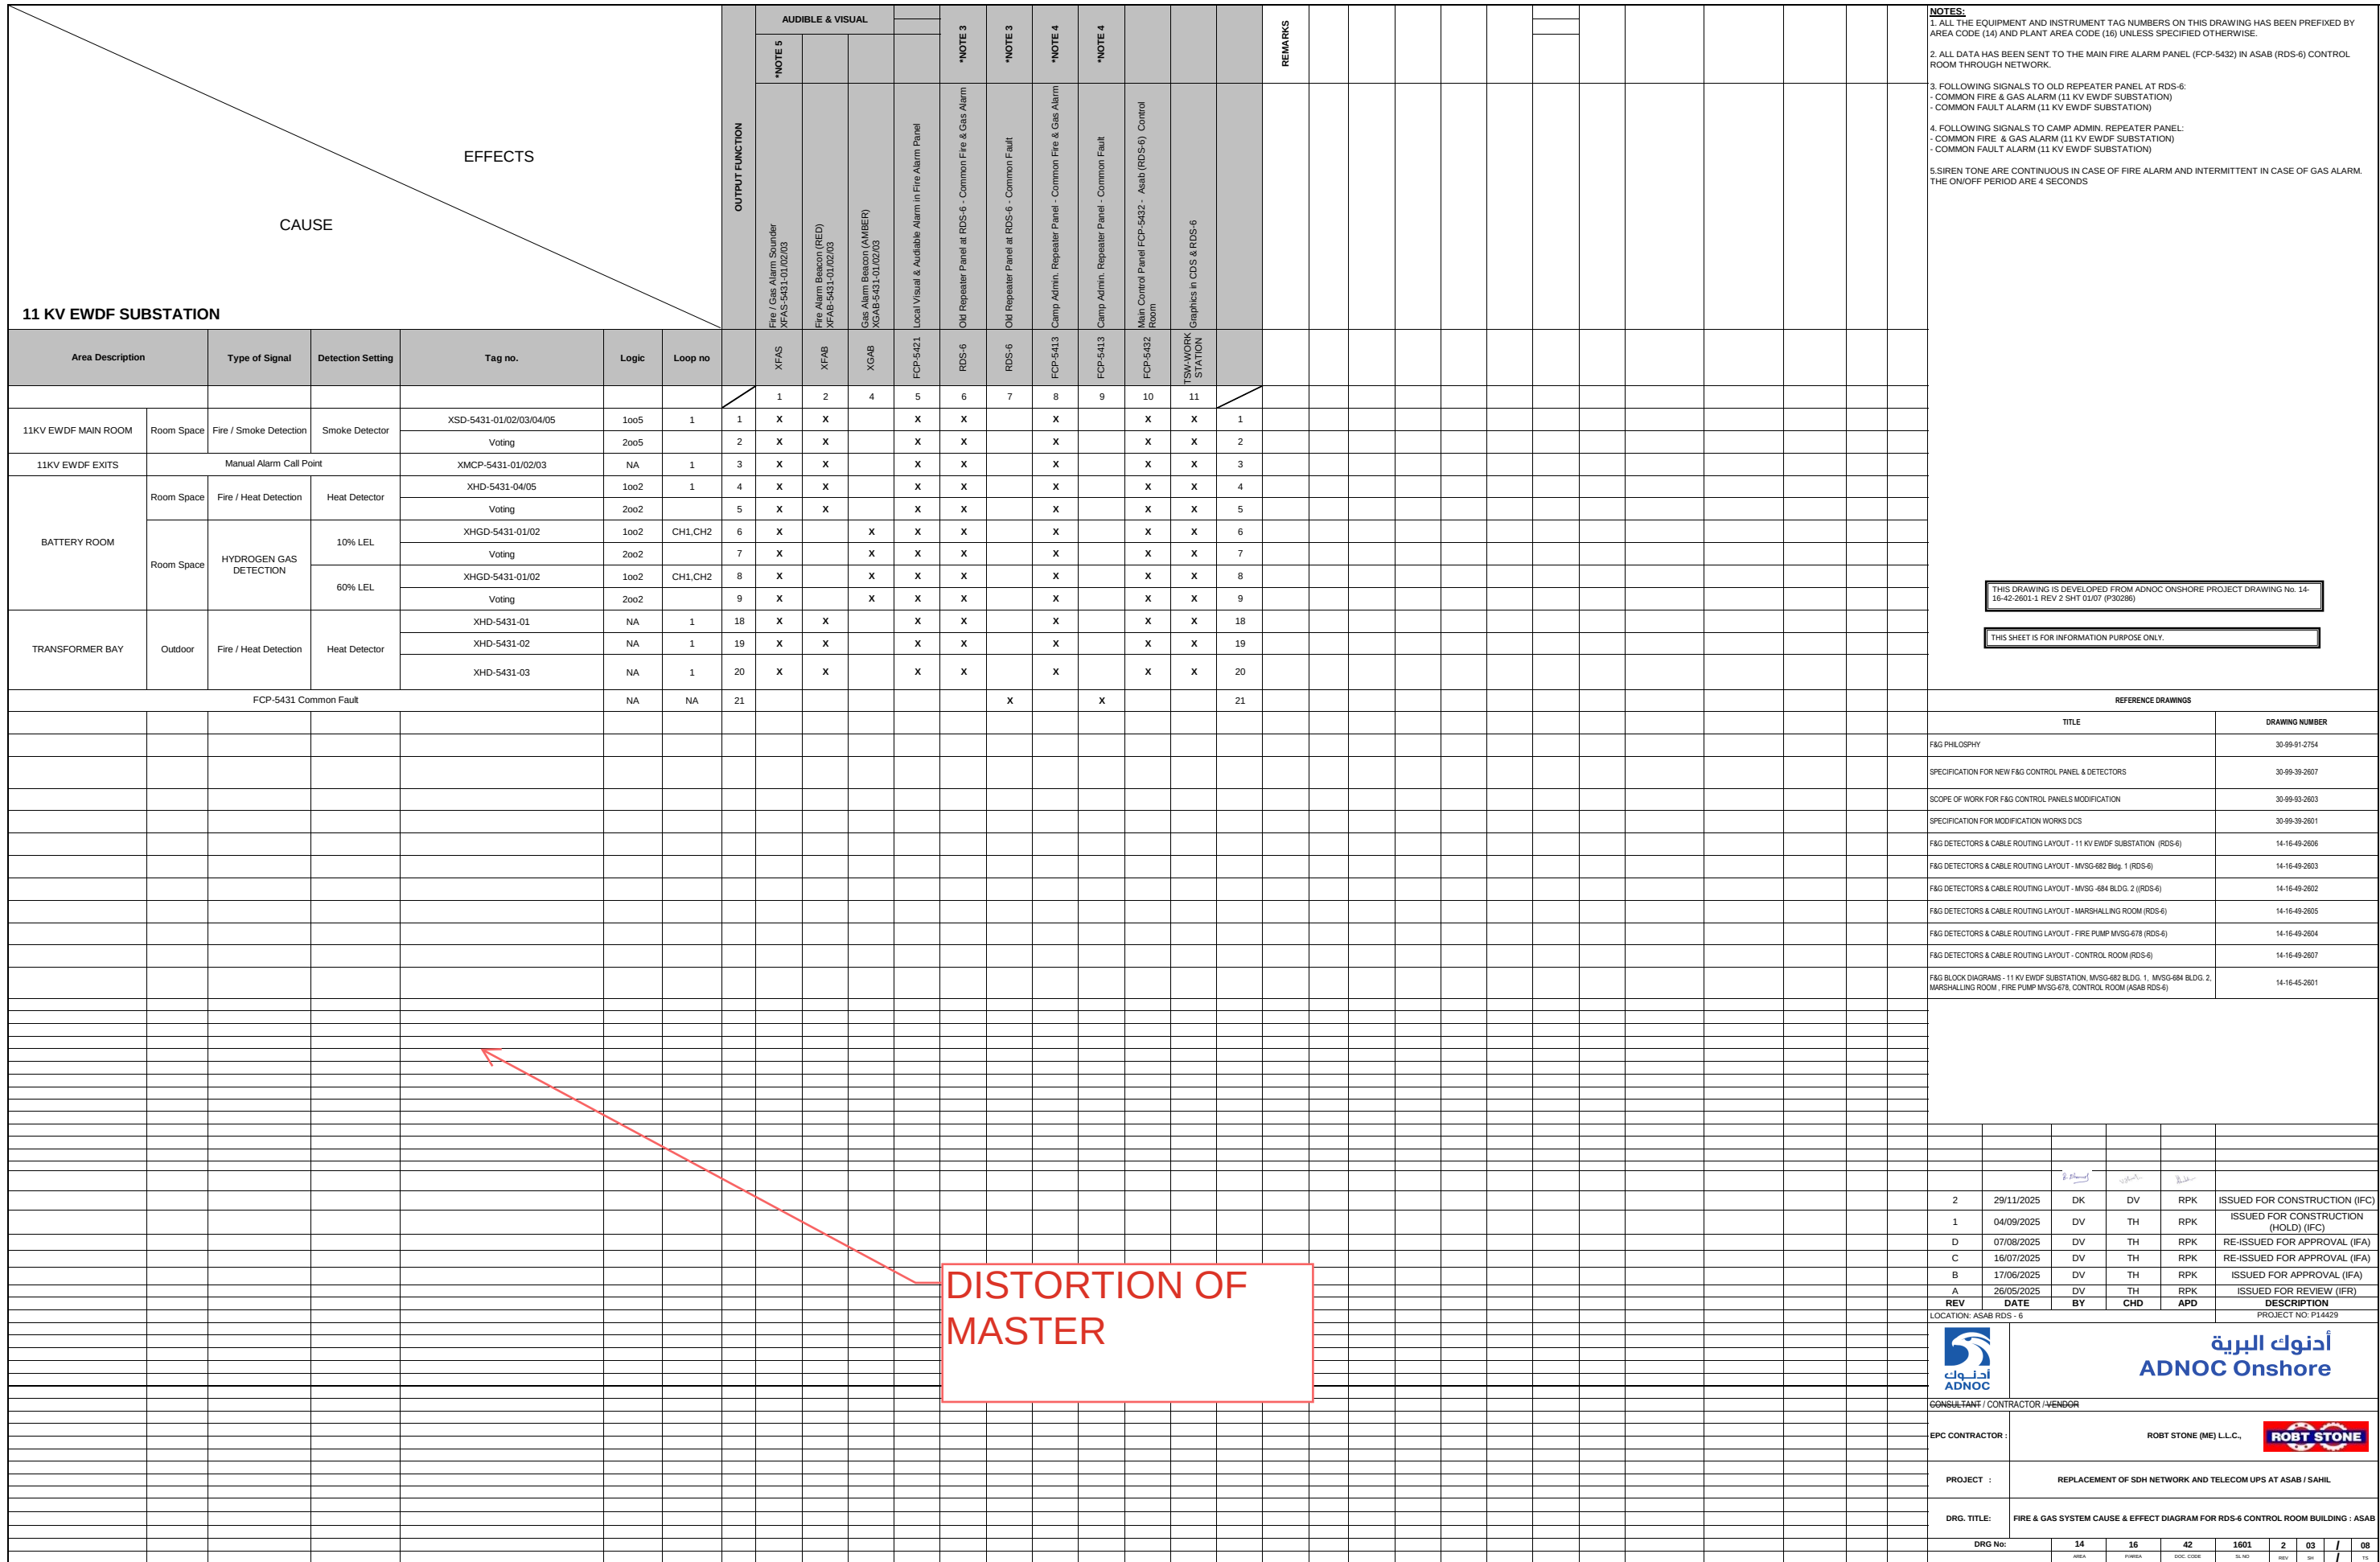

[illegible]

[illegible]

CONTROL ROOM										EFFECTS										CAUSE																																																																																																																																																																																																																																																																																																																																																																																																																																																																																																																																																																																																
Area Description		Type of Signal	Detection Setting	Tag no.	Logic	Loop no	OUTPUT FUNCTION										REMARKS																																																																																																																																																																																																																																																																																																																																																																																																																																																																																																																																																																																																			

CONTROL ROOM							TAG													REMARKS	REV
Area Description		Type of Signal	Detection Setting	Tag no.	Logic	Loop no	EFFECTS														
							IS IT AS PER FACE TO FACE MEETING?														
							WHY NOT SAME LEVEL OF DESCRIPTION FOLLOWED?														
							DISTORTION OF MASTER														