
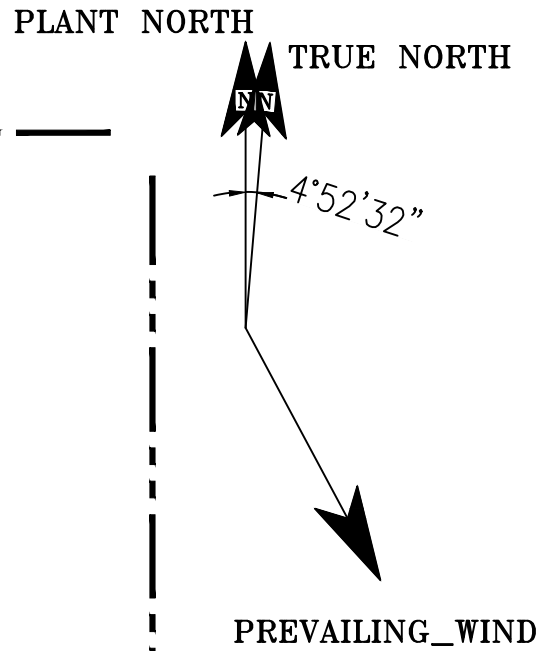


COPYRIGHT © 2020 ALL RIGHTS RESERVED. THIS DOCUMENT IS ISSUED IN ACCORDANCE WITH AN AGREEMENT BETWEEN ROBT STONE AND ITS CLIENTS, WHICH SETS OUT THE ENTIRE RIGHTS, OBLIGATIONS AND LIABILITIES OF THE PARTIES WITH RESPECT TO THE CONTENT AND USE OF THIS DOCUMENT.  
FILE PATHWAY: X:\9.0 Engineering\9.5 Electrical\9.5.2 Elec. Dwg's\01\_Plg.1 - P30255\03\_Earth\Shah\30255-29-01-59-1632-1.dwg

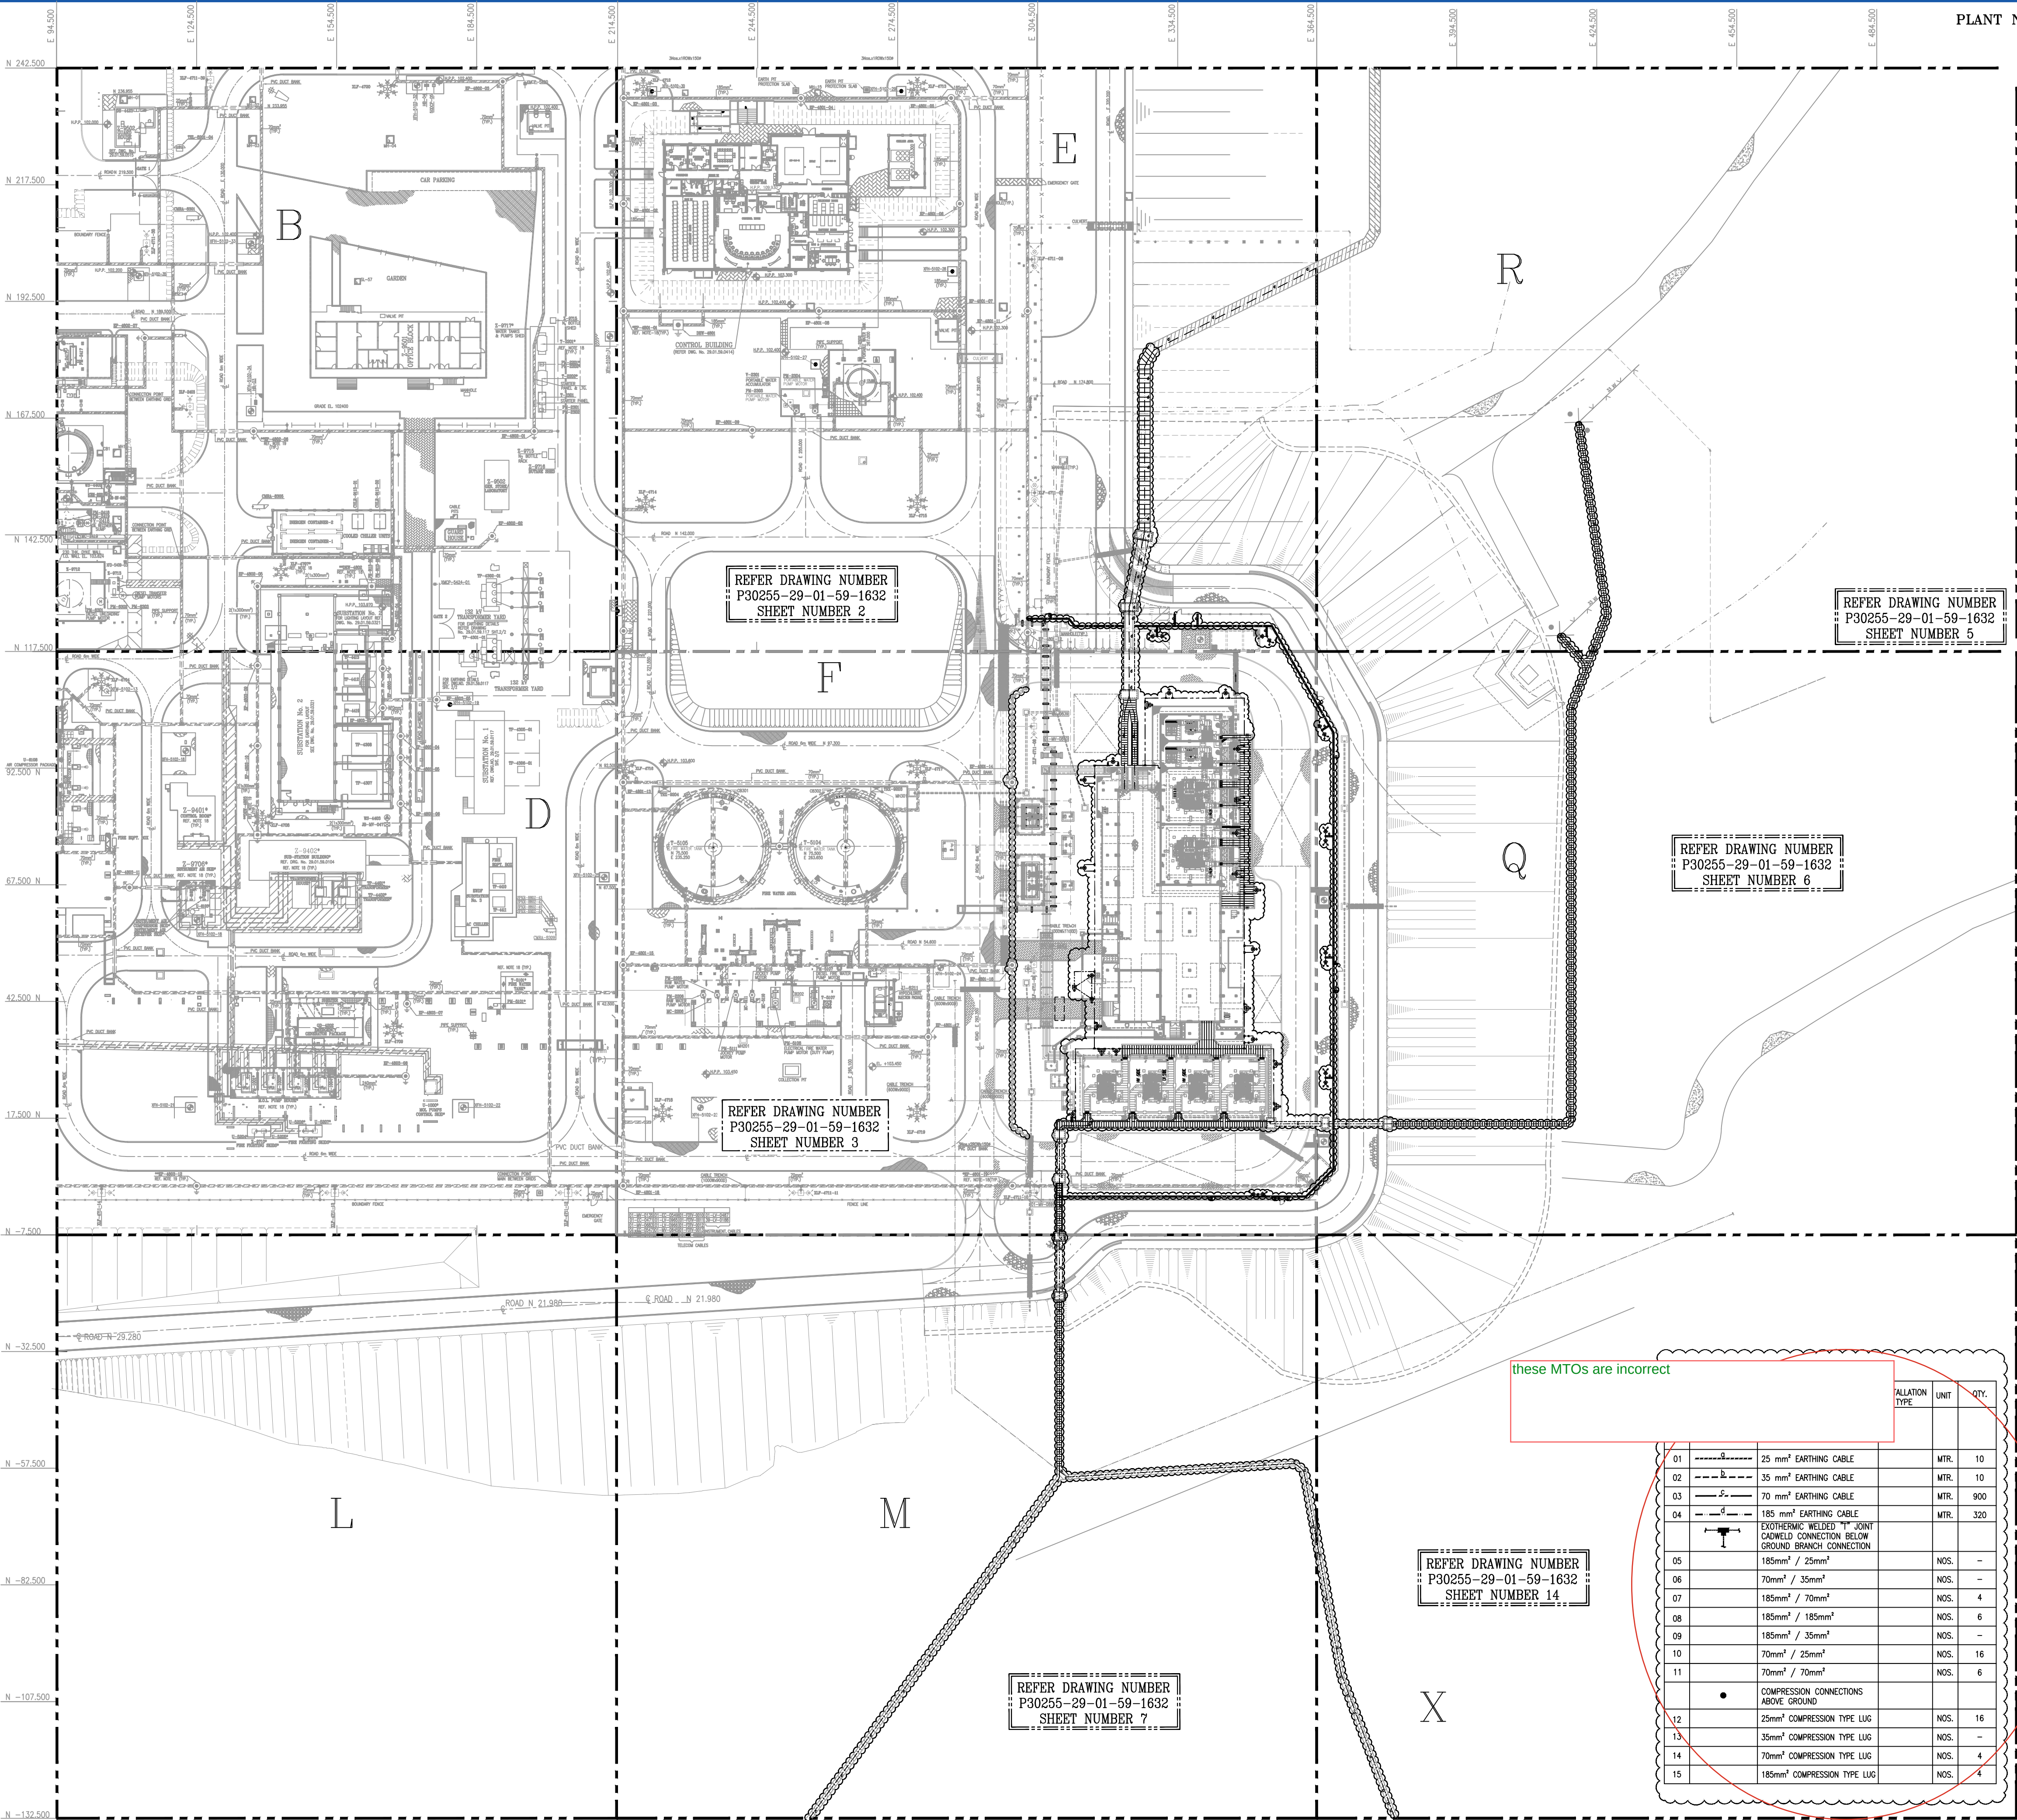

- NOTES**
1. ALL EQUIPMENT AND INSTRUMENT TAG NUMBERS ON THIS DRAWING ARE PREFIXED BY AREA CODE (29) AND PLANT AREA CODE (01) UNLESS SPECIFIED OTHERWISE.
  2. ALL DIMENSIONS ARE IN MILLIMETERS, ALL ELEVATION AND CO-ORDINATES ARE IN METERS UNLESS SPECIFIED OTHERWISE.
  3. BEFORE MAKING BOLTED CONNECTION, ENSURE THAT ALL MATERIALS ARE CLEAN & FREE OF PAINT & GREASE. OXIDE INHIBITING COMPOUNDS SHALL BE APPLIED TO ALL ABOVE GROUND BOLTED & COMPRESSION TYPE EARTH CONNECTIONS.
  4. METALLIC TAPE OR LIGHTNING DOWN CONDUCTOR SHALL BE CONNECTED TO DEDICATED EARTH ELECTRODE THROUGH A REMOVABLE LINK. THE DEDICATED EARTH ELECTRODE SHALL BE DIRECTLY CONNECTED TO THE EARTH RING.
  5. EARTHING CABLES EMANATING FROM THE TRENCHES TO THE EQUIPMENT & STRUCTURE AND PASSING THROUGH PAVED AREAS SHALL BE LAID IN UPVC SLEEVES OF ADEQUATE SIZES. FIELD TO THE EXACT POSITION DETERMINE OF SLEEVE(S) FOR EASE OF INSTALLATION.
  6. ALL EQUIPMENT AND METAL WORKS (CONTROL PANELS, CABLE LADDER, ETC) SHALL BE CONNECTED TO THE EARTHING SYSTEM.
  7. THIS DRAWING IS VALID FOR ALL ELECTRICAL INSTALLATIONS. ALL CIVIL AND MECHANICAL FACILITIES AS SHOWN FOR INFORMATION ONLY.
  8. INDIVIDUAL EQUIPMENT BONDING (SUCH AS BUT NOT LIMITED TO SOCKET, LIGHTING EQUIPMENT, SUPPORTING STRUCTURES, GATES, STAIRS, ETC.) SHALL BE CONNECTED TO THE EARTHING SYSTEM.
  9. ALL EARTHING CONDUCTORS SHALL RUN IN ELECTRICAL CABLE TRENCHES WHEREVER POSSIBLE. IF EARTHING CABLE RUNS INDEPENDENTLY FROM MAIN TRENCH THEY SHALL BE MINIMUM 500mm BELOW FINISHED GRADE LEVEL. GENERAL PLANT EARTHING CABLES SHALL BE 70sq.mm.
  10. ALL ABOVE GRADE GROUND CONNECTIONS SHALL BE CRAWLED TYPE. BELOW GRADE GROUND CONNECTIONS SHALL BE CRAWLED TYPE.
  11. EARTHING NETWORK SHALL BE MESHED. CRAWLED TYPE CABLE CONNECTION BETWEEN THE DEEP EARTHING WELLS AND THE CONNECTION BETWEEN EARTHING RING SUBSTATION AND DEEP EARTHING.
  12. THE PERIMETER FENCE SHALL BE EARTHED AT EVERY 25MTR. INTERVALS MAXIMUM.
  13. ALL METAL SUPPORTS, CABLE TRUNKING, JUNCTION BOXES, STEEL CONDUITS (IF USED) AND METAL TRAYS, LADDERS & ANGLES FOR CABLE SUPPORT SHALL BE BOUNDARY WITH A MINIMUM OF 25mm EARTHING WIRE UP TO THE NEAREST ELECTRICAL SAFETY EARTH TO FORM A CONTINUOUS GROUND.
  14. THE EARTH BUSBAR SHALL BE MOUNTED TO THE NEAREST STRUCTURE AS MUCH AS POSSIBLE TO SUIT THE SITE CONDITIONS.
  15. LOCATION OF DEEP WELL ELECTRODE IS INDICATIVE ONLY AND SAME SHALL BE IDENTIFIED SUIT SITE CONDITIONS.
  16. DOWN-CONDUCTORS (COPPER TAPE) OF LIGHTNING PROTECTION SYSTEM SHALL NOT BE USED FOR ELECTRICAL EQUIPMENT EARTHING.

| DRAWING REFERENCE                                                   |                      |
|---------------------------------------------------------------------|----------------------|
| TITLE                                                               | DRG. No.             |
| OVERALL PLOT PLAN PROCESS AREA CDS : SHAH                           | P30255-29-01-04-1601 |
| ELECTRICAL DESIGN BASIS                                             | P30377-30-99-61-1673 |
| ELECTRICAL EQUIPMENT LAYOUT 33kV SUBSTATION (INSTALLATION) SHAH-CDS | P30255-29-01-59-1641 |
| ELECTRICAL EARTHING LAYOUT 33kV SUBSTATION (INSTALLATION) SHAH-CDS  | P30255-29-01-59-1607 |
| TYPICAL INSTALLATION STANDARDS-EARTHING                             | P30377-30-99-67-1602 |
| EARTHING & LIGHTNING PROTECTION PHILOSOPHY                          | P30377-30-99-91-1675 |
| ELECTRICAL SYSTEM GENERAL NOTES AND SYMBOL                          | P30377-30-99-67-1601 |

|              |   |   |   |   |   |
|--------------|---|---|---|---|---|
|              |   |   | P | N |   |
|              | G | A | B | E | R |
|              | H | C | D | F | Q |
|              | J | K | L | M | X |
| (CDS)        |   |   |   |   |   |
| (FLARE AREA) |   | A | B | N |   |
|              | U | C | D | P |   |
|              |   | E | F | Q |   |
|              |   | G | H | R |   |
|              |   | J | K | S |   |
|              |   | L | M | T |   |
|              |   |   |   |   |   |
|              |   |   |   |   |   |
(\*) REPRESENT SECTION NOT DRAWN

KEY PLAN


CLOUDED PORTION DENOTES :  
THE SCOPE OF WORK UNDER THE PROJECT NO. P30255

THIS DRAWING IS DEVELOPED FROM FEED DRAWING NO.  
P30255-29-01-59-0606-2 REV.1 SHT. 1/5 (P30255)

|                                                                                                                                                      |            |                |            |                    |                   |  |  |  |  |
|------------------------------------------------------------------------------------------------------------------------------------------------------|------------|----------------|------------|--------------------|-------------------|--|--|--|--|
|                                                                                                                                                      |            |                |            |                    |                   |  |  |  |  |
| A                                                                                                                                                    | 28/11/2025 | JS             | SG         | RPK                | ISSUED FOR REVIEW |  |  |  |  |
| REV.                                                                                                                                                 | DATE       | DR'N.          | CH'D.      | AP'D.              | DESCRIPTION       |  |  |  |  |
| SCALE: 1:500                                                                                                                                         |            | LOCATION: SHAH |            | PROJECT No. P30255 |                   |  |  |  |  |
|  <b>أدنوك البرية</b><br><b>ADNOC Onshore</b>                    |            |                |            |                    |                   |  |  |  |  |
| CONSULTANT / CONTRACTOR / VENDOR                                                                                                                     |            |                |            |                    |                   |  |  |  |  |
|  <b>ROBT STONE (ME) LLC</b><br>P.O. Box 30588<br>Abu Dhabi, UAE |            |                |            |                    |                   |  |  |  |  |
| DRAWING No.                                                                                                                                          |            |                |            |                    |                   |  |  |  |  |
| PROJECT: REPLACEMENT OF AGED ELECTRICAL EQUIPMENT<br>AT SE FIELD                                                                                     |            |                |            |                    |                   |  |  |  |  |
| DRG. TITLE:<br><b>EXTERNAL ELECTRICAL EARTHING LAYOUT</b><br><b>33kV SUBSTATION (INSTALLATION)</b><br><b>SHAH : CDS</b>                              |            |                |            |                    |                   |  |  |  |  |
| DRG. No.                                                                                                                                             | 2901591632 | A              | 1/14       |                    |                   |  |  |  |  |
| AREA                                                                                                                                                 | P/AREA     | DOC. CODE      | SERIAL No. | REV.               | SHT               |  |  |  |  |



COPYRIGHT © 2020 ALL RIGHTS RESERVED. THIS DOCUMENT IS ISSUED IN ACCORDANCE WITH AN AGREEMENT BETWEEN ROBT STONE AND ITS CLIENTS, WHICH SETS OUT THE ENTIRE RIGHTS, OBLIGATIONS AND LIABILITIES OF THE PARTIES WITH RESPECT TO THE CONTENT AND USE OF THIS DOCUMENT.  
FILE PATHWAY: X:\9.0 Engineering\9.5.2 Elec. Dwg's\01. Pkg.1 - P30255\03. Earth\Shah\30255-29-01-59-1632-2.dwg

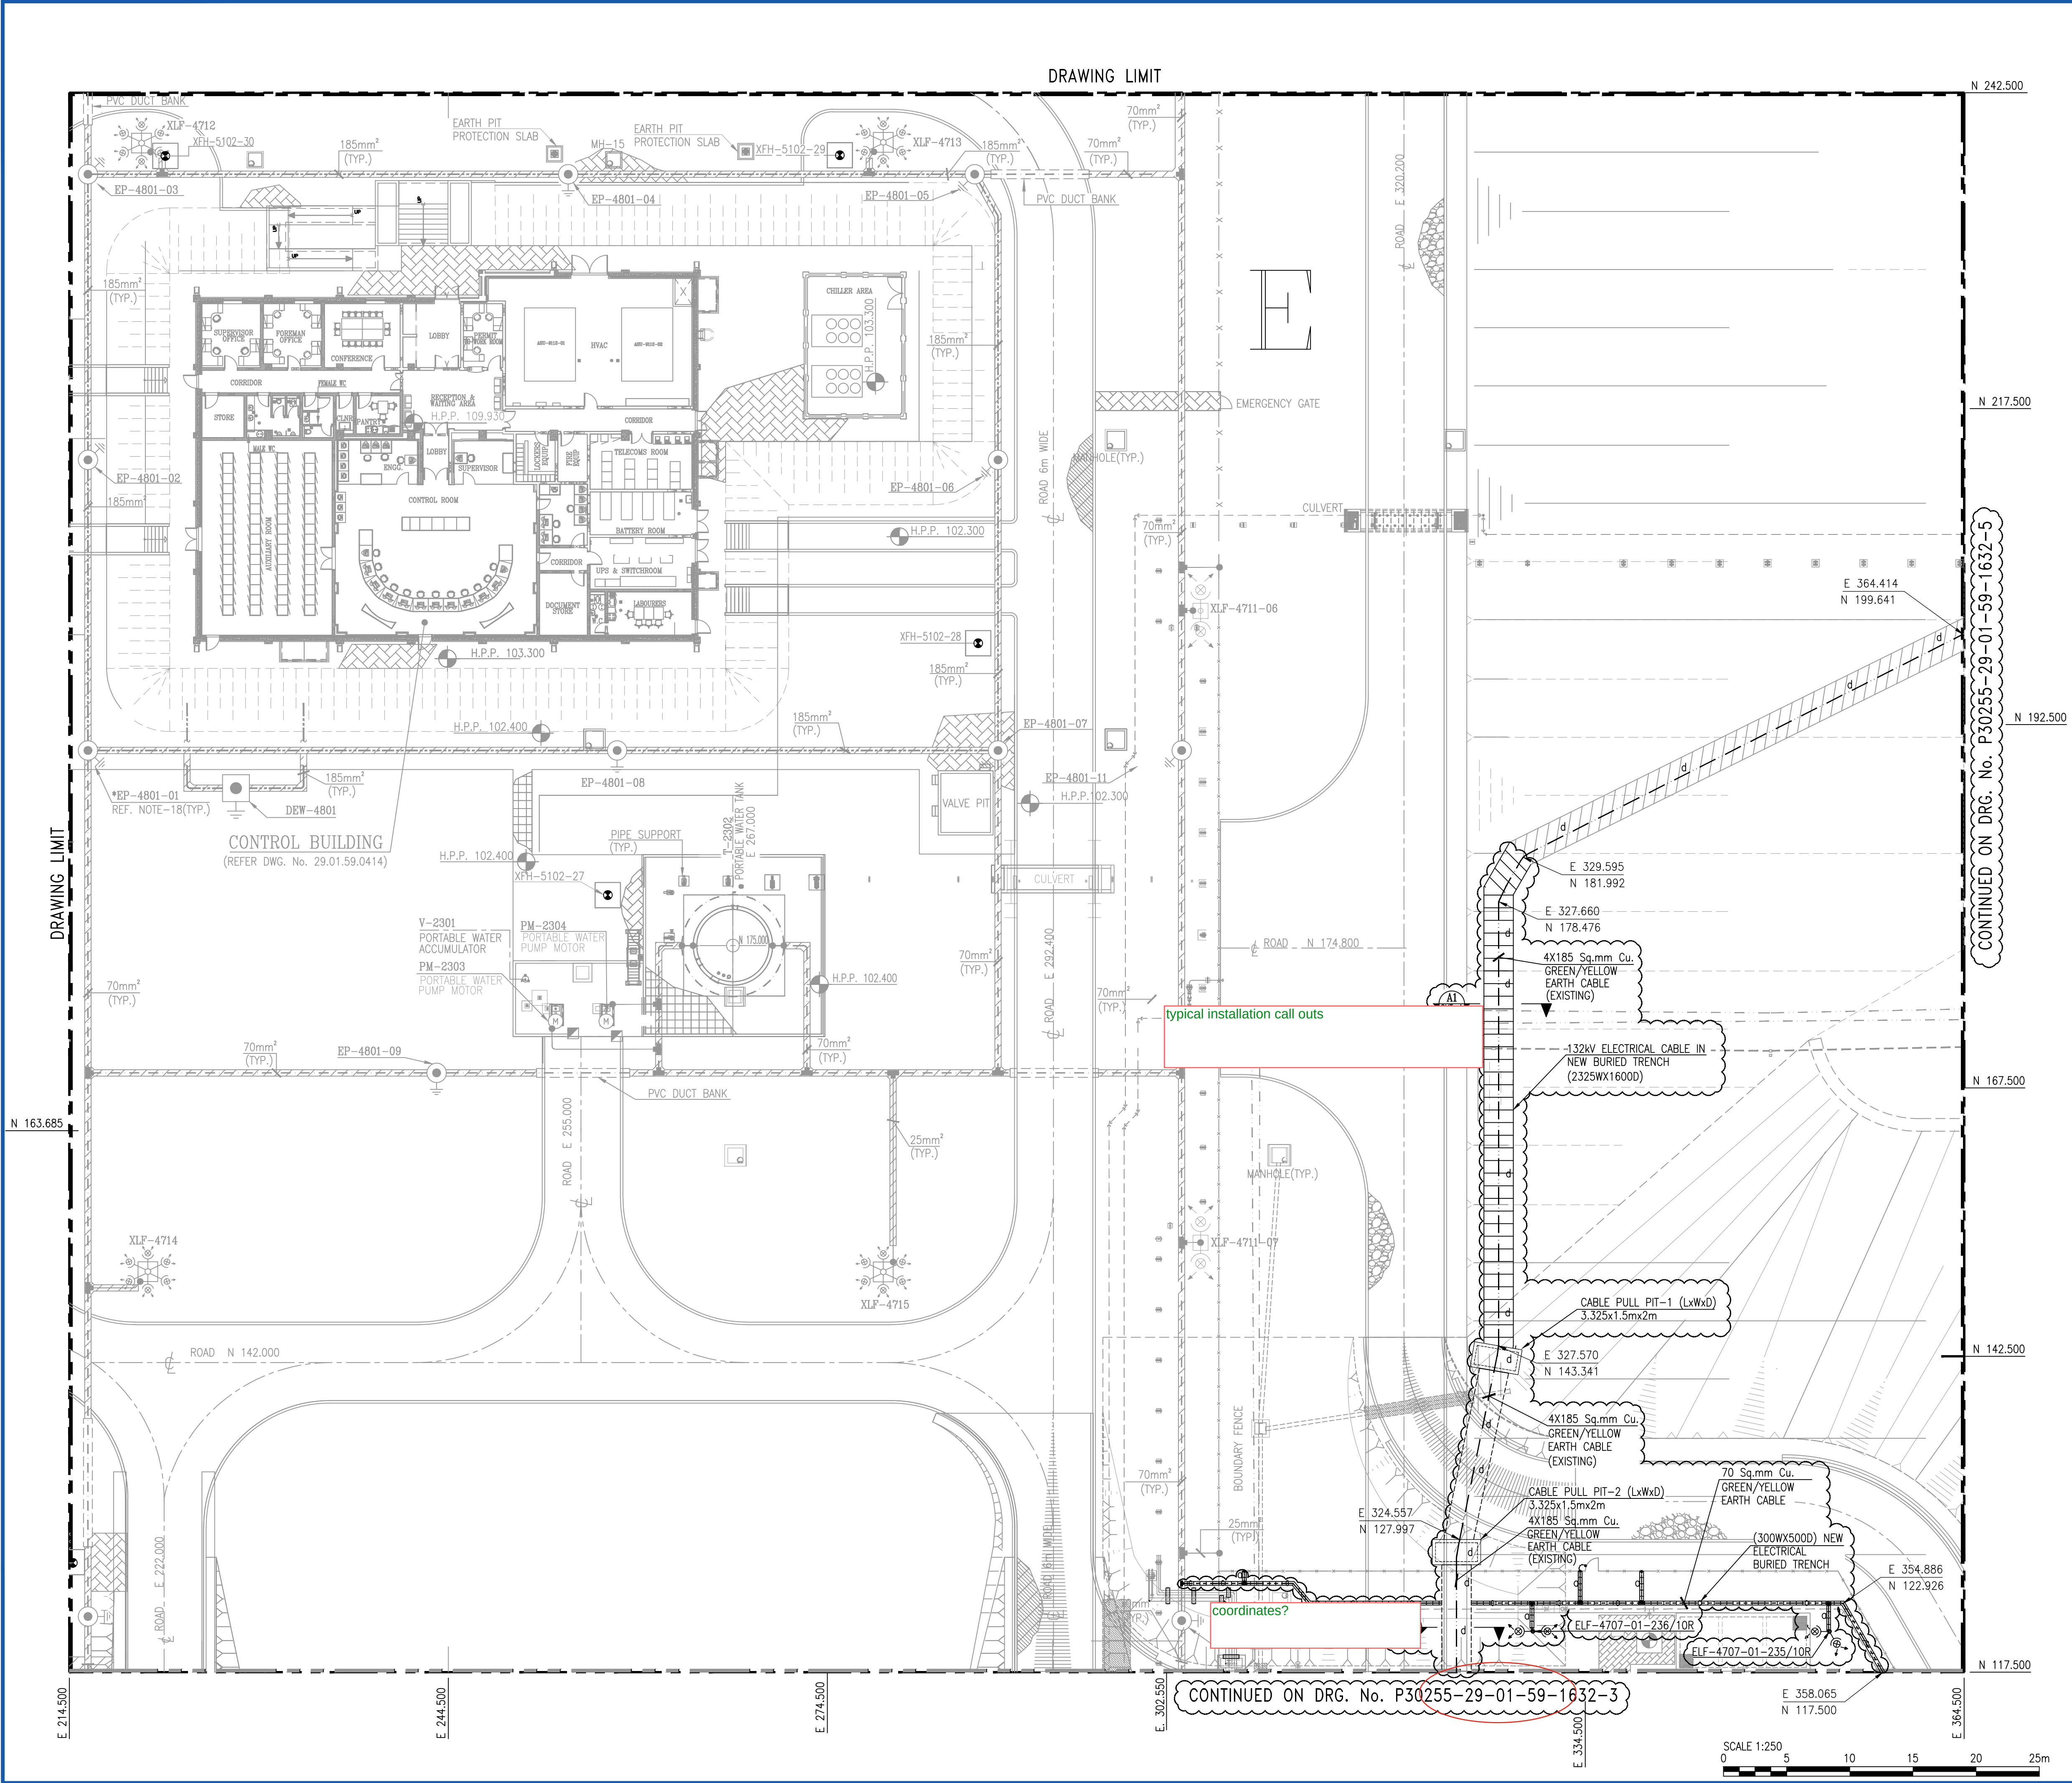

NOTES

1. ALL DIMENSIONS ARE IN MILLIMETERS AND CO-ORDINATES ARE IN METERS UNLESS OTHERWISE NOTED.  
2. FOR GENERAL NOTES, LEGENDS & REFERENCE DRAWINGS REFER SHEET 1 OF THIS DRAWING.

THIS DRAWING

|   |   |   |   |
|---|---|---|---|
|   | P | N |   |
| G | A | B | E |
| H | C | D | F |
| J | K | L | M |
| U | A | B | N |
|   | C | D | P |
|   | E | F | Q |
|   | G | H | R |
|   | J | K | S |
|   | L | M | T |

(\*) REPRESENT SECTION NOT DRAWN

KEY PLAN

CLOUDED PORTION DENOTES :  
THE SCOPE OF WORK UNDER THE PROJECT NO. P30255

THIS DRAWING IS DEVELOPED FROM FEED DRAWING NO. P30255-29-01-59-0606-2 REV.1 SHT. 1/5 (P30255)

THIS DRAWING IS DEVELOPED FROM MASTER DRAWING NO. 29-01-59-0215-1 REV.1 SHT. 1/1

|      |            |       |       |       |                   |
|------|------------|-------|-------|-------|-------------------|
| REV. | DATE       | DR'N. | CH'D. | AP'D. | DESCRIPTION       |
| A    | 28/11/2025 | JS    | SG    | RPK   | ISSUED FOR REVIEW |

SCALE: 1:250    LOCATION: SHAH    PROJECT No. P30255

**أدنوك البرية**  
**ADNOC Onshore**

CONSULTANT / CONTRACTOR / VENDOR

**ROBT STONE (MC) LLC**  
P.O. Box: 35588  
Abu Dhabi, UAE


DRAWING No. \_\_\_\_\_

PROJECT: REPLACEMENT OF AGED ELECTRICAL EQUIPMENT AT SE FIELD

DRG. TITLE: **EXTERNAL ELECTRICAL EARTHING LAYOUT**  
**33kV SUBSTATION (INSTALLATION)**  
**SHAH : CDS**

|         |            |           |            |
|---------|------------|-----------|------------|
| DRG.No. | 2901591632 | A         | 2/14       |
| AREA    | P/AREA     | DOC. CODE | SERIAL No. |
| REV.    | SHT        | OF        | SHT        |

COPYRIGHT © 2020 ALL RIGHTS RESERVED. THIS DOCUMENT IS ISSUED IN ACCORDANCE WITH AN AGREEMENT BETWEEN ROBT STONE AND IT'S CLIENTS, WHICH SETS OUT THE ENTIRE RIGHTS, OBLIGATIONS AND LIABILITIES OF THE PARTIES WITH RESPECT TO THE CONTENT AND USE OF THIS DOCUMENT.  
FILE PATHWAY: X:\9.0 Engineering\9.5 Electrical\9.5.2 Elec. Dwg's\01. Pkg.1 - P30255\03. Earth\Shah\30255-29-01-59-1632 - Rev. A\04. Native File\30255-29-01-59-1632-3.dwg

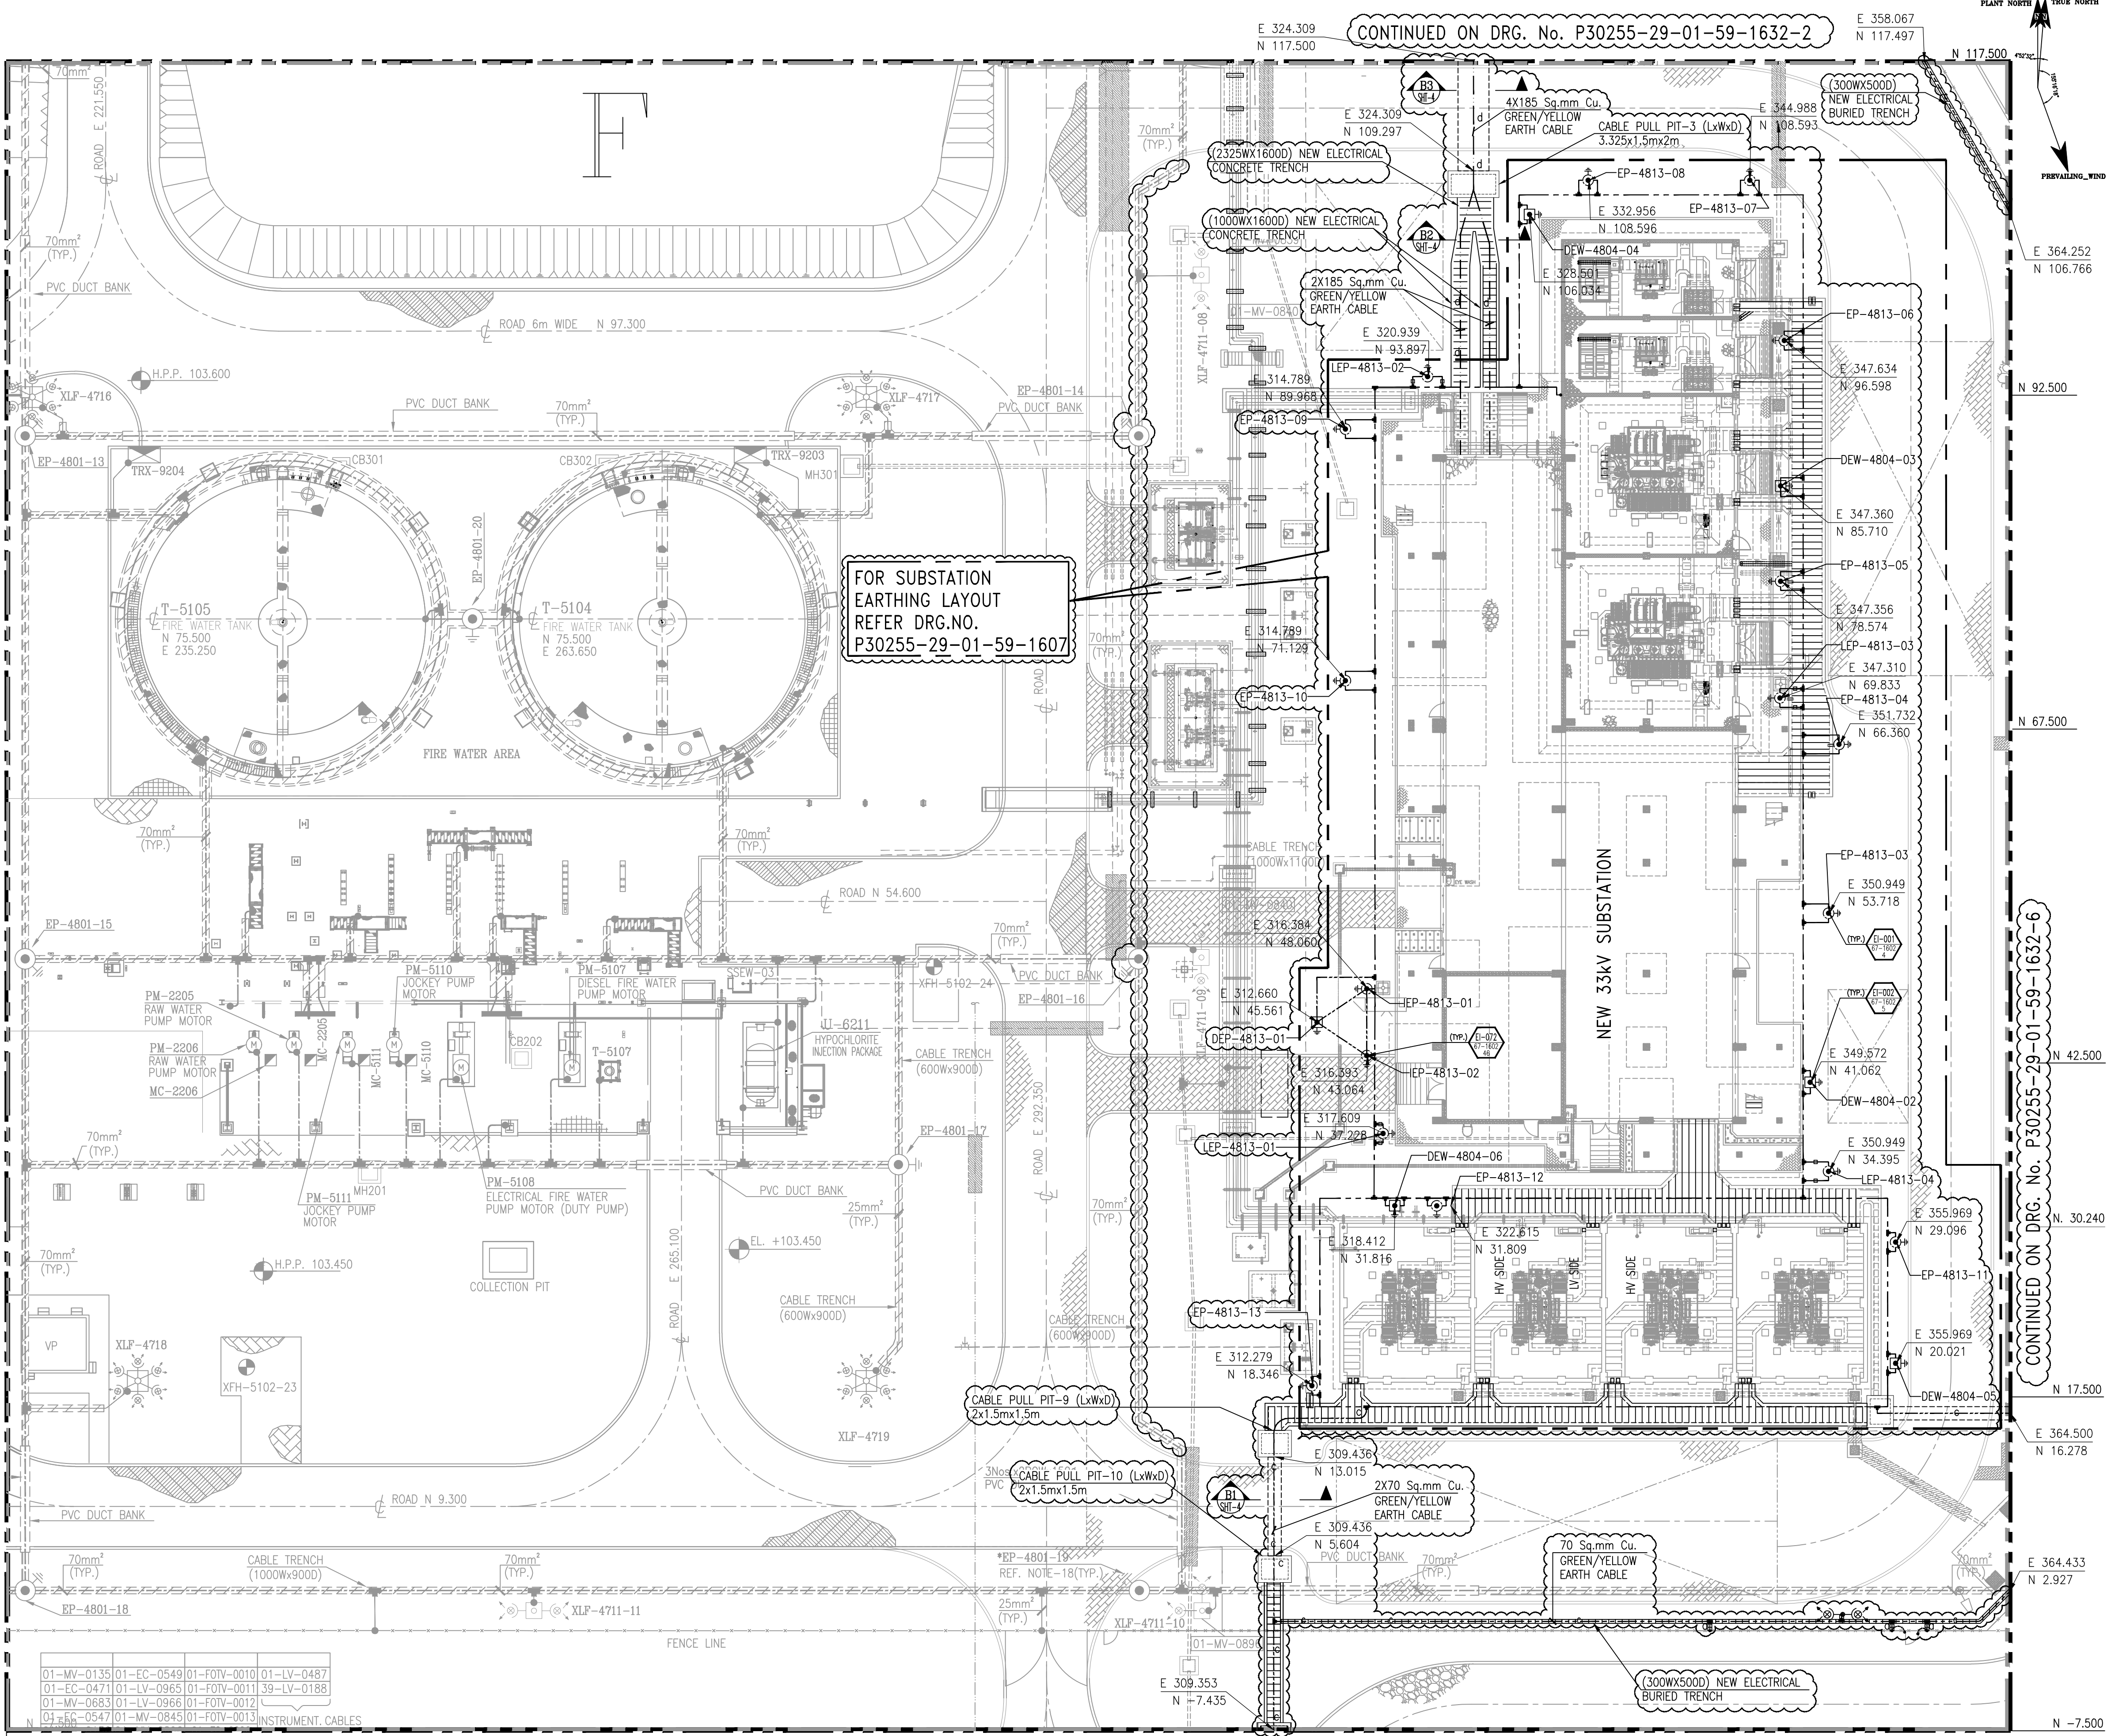

- NOTES
- 1. ALL DIMENSIONS ARE IN MILLIMETERS AND CO-ORDINATES ARE IN METERS UNLESS OTHERWISE NOTED.
  - 2. FOR GENERAL NOTES, LEGENDS & REFERENCE DRAWINGS REFER SHEET 1 OF THIS DRAWING.

(CDS)  
(FLARE AREA)

|   |   |   |   |   |
|---|---|---|---|---|
|   |   | P | N |   |
| G | A | B | E | R |
| H | C | D | F | Q |
| J | K | L | M | X |
| U |   | A | B | N |
|   |   | C | D | P |
|   |   | E | F | Q |
|   |   | G | H | R |
|   |   | J | K | S |
|   |   | L | M | T |

(\*) REPRESENT SECTION NOT DRAWN

- CLOUDED PORTION DENOTES :  
THE SCOPE OF WORK UNDER THE PROJECT NO. P30255
- THIS DRAWING IS DEVELOPED FROM FEED DRAWING NO.  
P30255-29-01-59-0606-2 REV.1 SHT. 1/5 (P30255)
- THIS DRAWING IS DEVELOPED FROM MASTER DRAWING NO.  
29-01-59-0216-1 REV.1 SHT. 1/1

|      |            |       |       |       |                   |
|------|------------|-------|-------|-------|-------------------|
| REV. | DATE       | DR'N. | CH'D. | AP'D. | DESCRIPTION       |
| A    | 28/11/2025 | JS    | SG    | RPK   | ISSUED FOR REVIEW |

SCALE: 1:250    LOCATION: SHAH    PROJECT No. P30255



**ADNOC Onshore**

CONSULTANT / CONTRACTOR / VENDOR

**ROBT STONE** (ME) LLC  
P.O. Box 39588  
Abu Dhabi, UAE


DRAWING No. \_\_\_\_\_

PROJECT: REPLACEMENT OF AGED ELECTRICAL EQUIPMENT AT SE FIELD

DRG. TITLE: **EXTERNAL ELECTRICAL EARTHING LAYOUT 33kV SUBSTATION (INSTALLATION) SHAH : CDS**

|          |            |           |            |
|----------|------------|-----------|------------|
| DRG. NO. | 2901591632 | A         | 3/14       |
| AREA     | P/AREA     | DOC. CODE | SERIAL No. |
| REV.     | SHT        | OF        | SHT        |

COPYRIGHT © 2020 ALL RIGHTS RESERVED. THIS DOCUMENT IS ISSUED IN ACCORDANCE WITH AN AGREEMENT BETWEEN ROBT STONE AND IT'S CLIENTS, WHICH SETS OUT THE ENTIRE RIGHTS, OBLIGATIONS AND LIABILITIES OF THE PARTIES WITH RESPECT TO THE CONTENT AND USE OF THIS DOCUMENT.  
FILE PATHWAY: X:\9.0 Engineering\9.5 Electrical\9.5.2 Elec. Dwg's\01. Pkg.1 - P30255\03. Earth\L\Shoh\P30255-29-01-59-1632 - EL Sec-7A CDS\Rev. A\04. Native File\P30255-29-01-59-1632-4.dwg

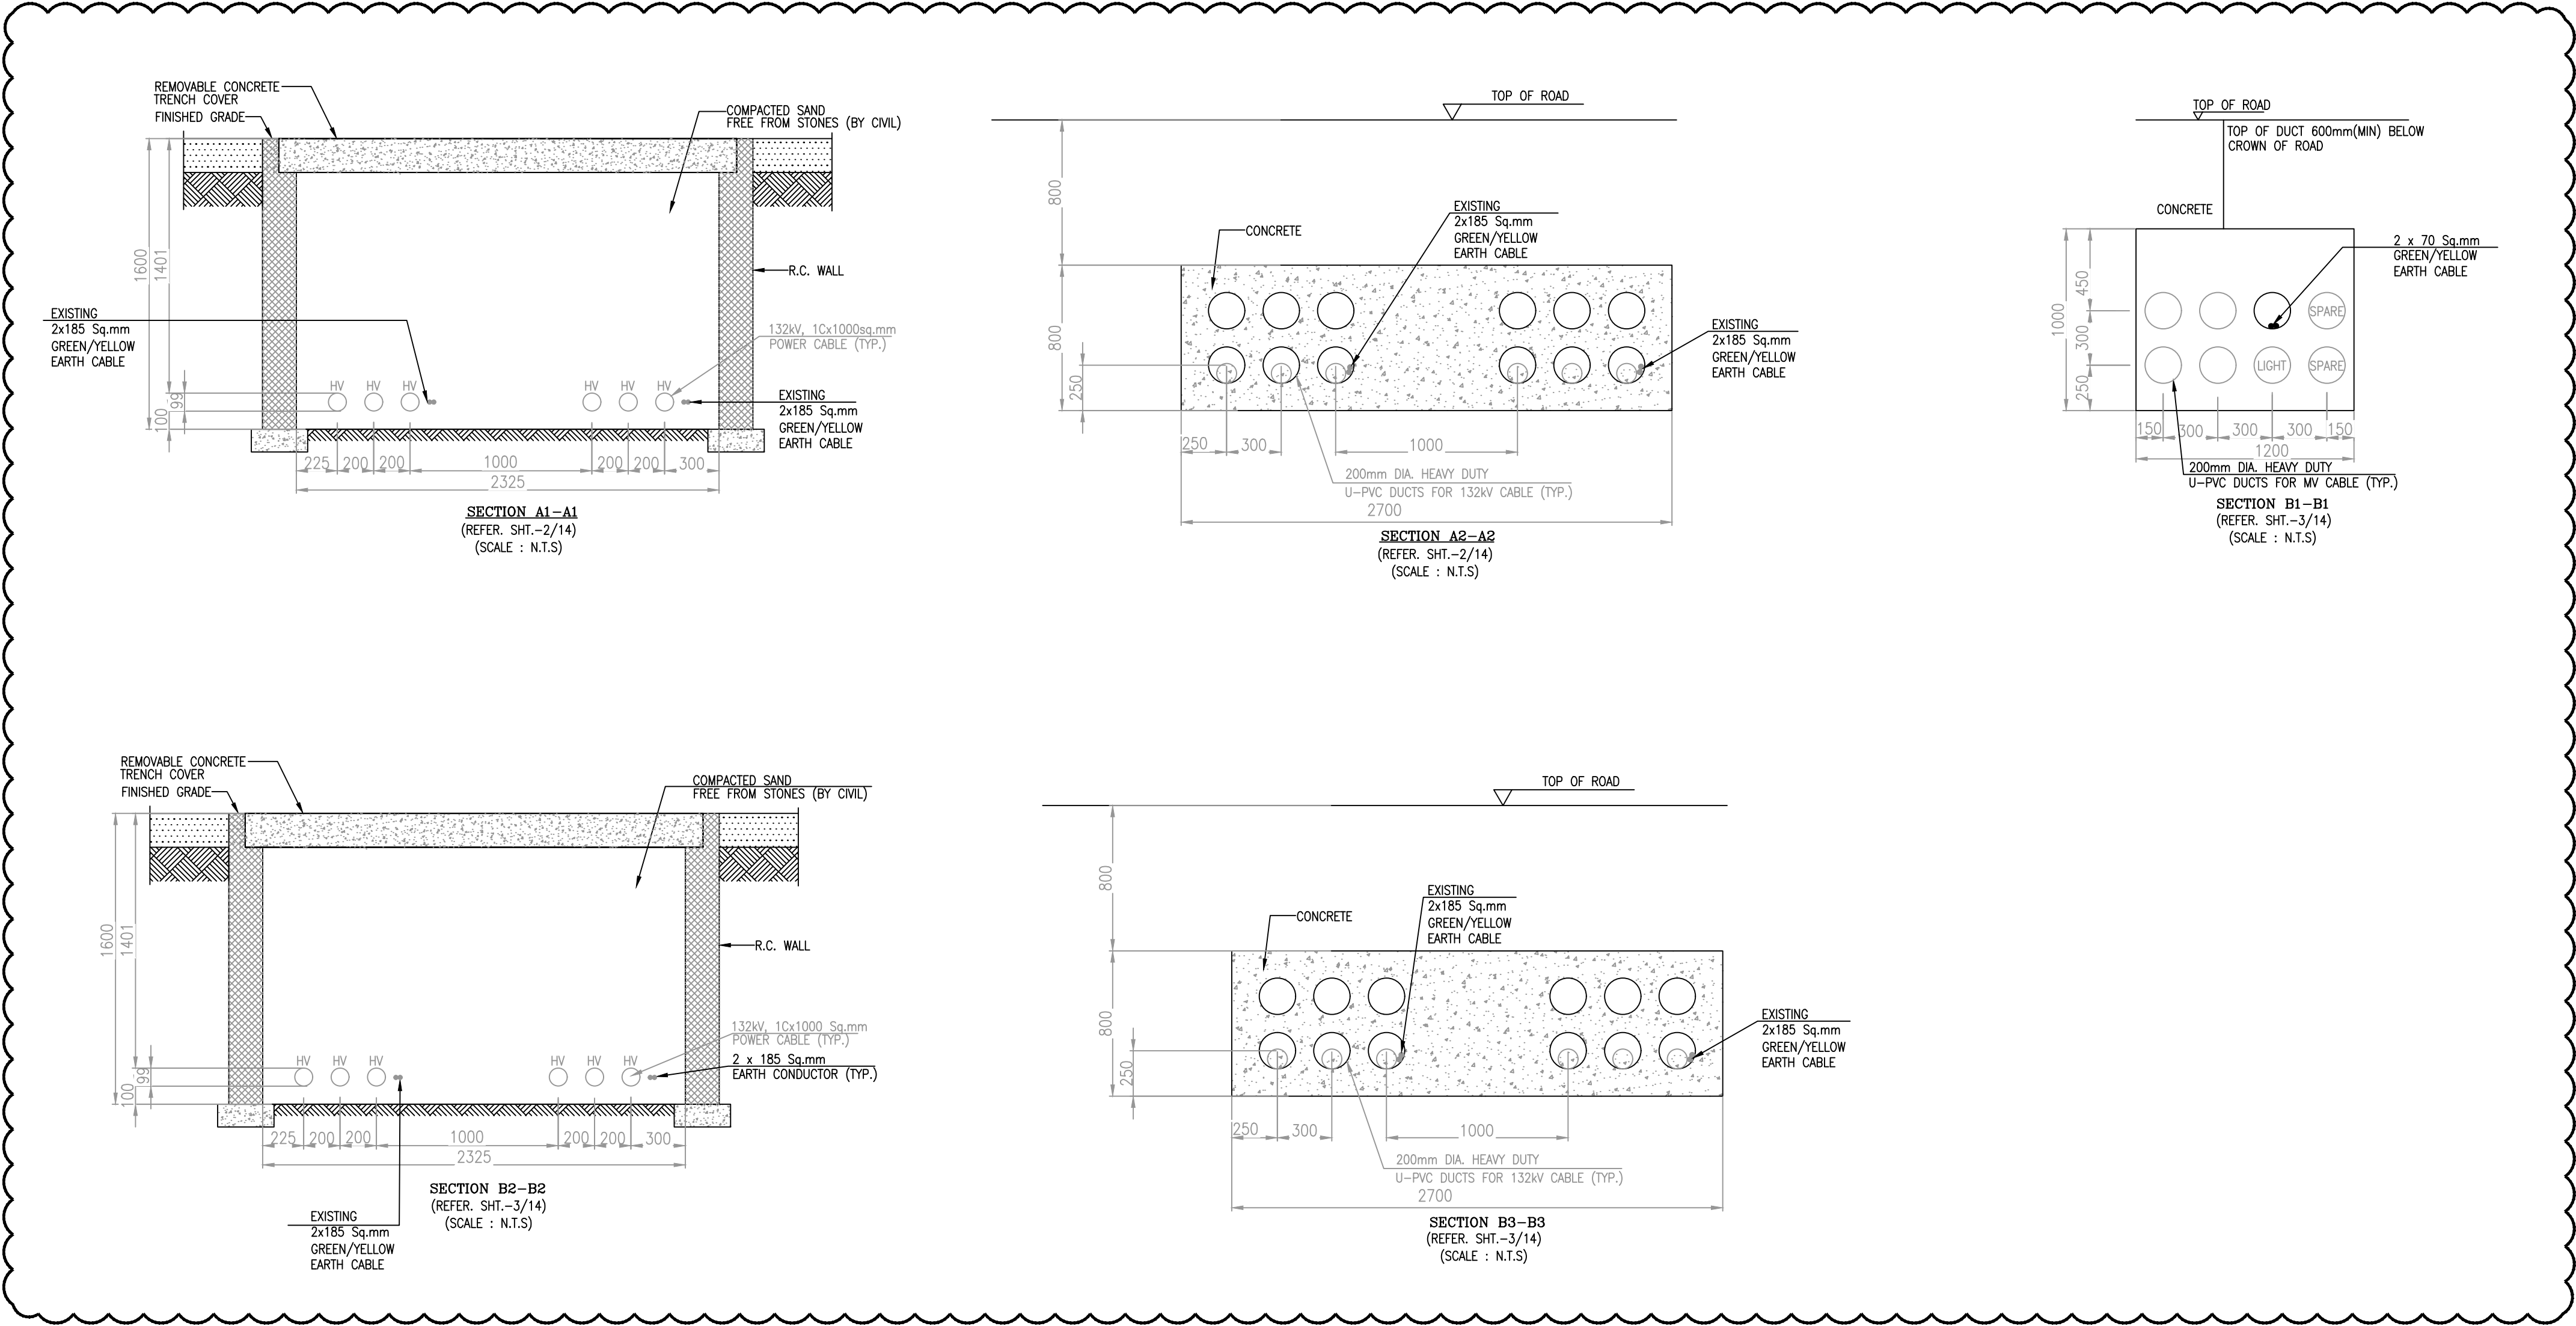

- NOTES
1. ALL DIMENSIONS ARE IN MILLIMETERS AND CO-ORDINATES ARE IN METERS UNLESS OTHERWISE NOTED.
  2. FOR GENERAL NOTES, LEGENDS & REFERENCE DRAWINGS REFER SHEET 1 OF THIS DRAWING.

CLOUDED PORTION DENOTES THE SCOPE UNDER PROJECT NO. P30255

|              |            |                |       |                    |                   |
|--------------|------------|----------------|-------|--------------------|-------------------|
|              |            |                |       |                    |                   |
| A            | 28/11/2025 | JS             | SG    | RPK                | ISSUED FOR REVIEW |
| REV.         | DATE       | DR'N.          | CH'D. | AP'D.              | DESCRIPTION       |
| SCALE: 1:250 |            | LOCATION: SHAH |       | PROJECT No. P30255 |                   |

**أدنوك البرية**  
**ADNOC Onshore**

CONSULTANT / CONTRACTOR / VENDOR

**ROBT STONE** (MC) LLC  
P.O. Box 35588  
Abu Dhabi, U.A.E


DRAWING No.

PROJECT: REPLACEMENT OF AGED ELECTRICAL EQUIPMENT  
AT SE FIELD

DRG. TITLE:  
**EXTERNAL ELECTRICAL EARTHING LAYOUT  
33kV SUBSTATION (INSTALLATION)  
SHAH : CDS**


DRG.No. **2901591632** A **4/14**

AREA P/AREA DOC. CODE SERIAL No. REV. SHT OF SHT

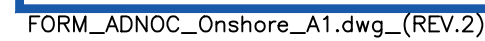


P30255-29-01-59-1632-5.DWG


1. ALL DIMENSIONS ARE IN MILLIMETERS AND CO-ORDINATES ARE IN METERS UNLESS OTHERWISE NOTED.  
2. FOR GENERAL NOTES, LEGENDS & REFERENCE DRAWINGS REFER SHEET 1 OF THIS DRAWING.

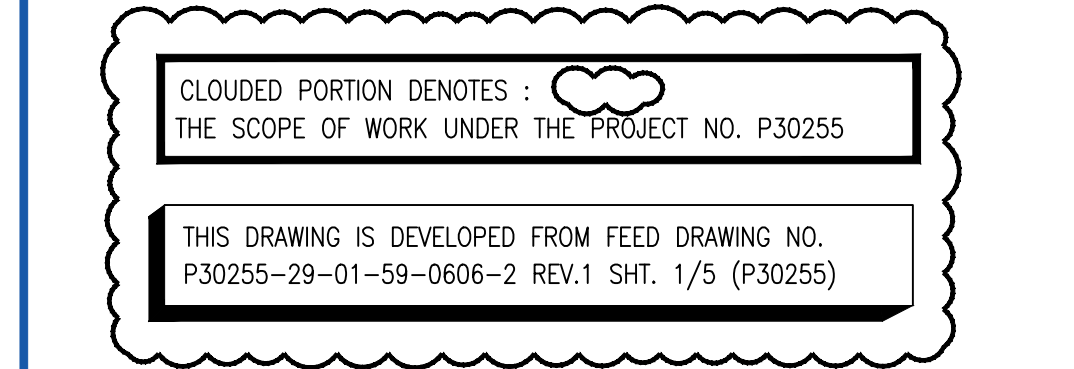


| A            | 28/11/2025 | JS             | SG    | RPK   | ISSUED FOR REVIEW  |
|--------------|------------|----------------|-------|-------|--------------------|
| REV.         | DATE       | DR'N.          | CH'D. | AP'D. | DESCRIPTION        |
| SCALE: 1:250 |            | LOCATION: SHAH |       |       | PROJECT No. P30255 |
 
|                                                                                                                                                                                                                                                                                                                                                                                                                                                                                                                                                                                                                                                                                  |                                                                                    |----------------------------------------------------------------------------------------------------------------------------------------------------------------------------------------------------------------------------------------------------------------------------------------------------------------------------------------------------------------------------------------------------------------------------------------------------------------------------------------------------------------------------------------------------------------------------------------------------------------------------------------------------------------------------------|------------------------------------------------------------------------------------|-----------|------------|------|-----|------|--|------|--------|-----------|------------|------|-----|--|--|--|--|--|----|--|--|--|--|--|-----|
| <br><b>ADNOC</b>                                                                                                                                                                                                                                                                                                                                                                                                                                                                                                                                                                            | <h1 style="margin: 0;">أدنوك البرية</h1> <h2 style="margin: 0;">ADNOC Onshore</h2> |           |            | CONSULTANT / CONTRACTOR / WENDOR                                                                                                                                                                                                                                                                                                                                                                                                                                                                                                                                                                                                                                                 |                                                                                    |           | <div style="display: flex; justify-content: space-between; align-items: center;"> <div style="border: 2px solid red; padding: 5px; text-align: center;">  </div> <div style="text-align: right;"> <b>ROBUSTONE (ME) LLC</b><br/>           P.O. Box. 39588<br/>           Abu Dhabi, UAE         </div> </div>                                                                                                                                                                                                                                                                              |                                                                                    |           | DRAWING No.                                                                                                                                                                                                                                                                                                                                                                                                                                                                                                                                                                                                                                                                      |                                                                                    |           | PROJECT: REPLACEMENT OF AGED ELECTRICAL EQUIPMENT<br>AT SE FIELD                                                                                                                                                                                                                                                                                                                                                                                                                                                                                                                                                                                                                 |                                                                                    |           | DRG. TITLE:<br><div style="text-align: center; font-weight: bold; font-size: 1.2em;">           EXTERNAL ELECTRICAL EARTHING LAYOUT<br/>           33kV SUBSTATION (INSTALLATION)<br/>           SHAH : CDS         </div>                                                                                                                                                                                                                                                                                                                                                                                                                                                       |                                                                                    |           | <table border="1" style="width: 100%; border-collapse: collapse;"> <tr> <td style="width: 10%;">DRG.No.</td> <td style="width: 30%; text-align: center; font-size: 1.5em;">2901591632</td> <td style="width: 10%; text-align: center; font-size: 1.5em;">A</td> <td style="width: 10%;"></td> <td style="width: 10%; text-align: center; font-size: 1.5em;">5/14</td> <td style="width: 10%;"></td> </tr> <tr> <td>AREA</td> <td>P/AREA</td> <td>DOC. CODE</td> <td>SERIAL No.</td> <td>REV.</td> <td>SHT</td> </tr> <tr> <td></td> <td></td> <td></td> <td></td> <td></td> <td>OF</td> </tr> <tr> <td></td> <td></td> <td></td> <td></td> <td></td> <td>SHT</td> </tr> </table> |                                                                                    | DRG.No.   | 2901591632 | A    |     | 5/14 |  | AREA | P/AREA | DOC. CODE | SERIAL No. | REV. | SHT |  |  |  |  |  | OF |  |  |  |  |  | SHT |
| DRG.No.                                                                                                                                                                                                                                                                                                                                                                                                                                                                                                                                                                                                                                                                          | 2901591632                                                                         | A         |            | 5/14 |     |      | AREA                                                                                                                                                                                                                                                                                                                                                                                                                                                                                                                                                                                                                                                                             | P/AREA                                                                             | DOC. CODE | SERIAL No. | REV. | SHT |      |  |                                                                                                                                                                                                                                                                                                                                                                                                                                                                                                                                                                                                                                                                                  |                                                                                    |           |            |      | OF  |      |  |                                                                                                                                                                                                                                                                                                                                                                                                                                                                                                                                                                                                                                                                                  |                                                                                    |           |            |      | SHT |      |  
COPYRIGHT © 2020 ALL RIGHTS RESERVED. THIS DOCUMENT IS ISSUED IN ACCORDANCE WITH AN AGREEMENT BETWEEN ROBT STONE AND ITS CLIENTS, WHICH SETS OUT THE ENTIRE RIGHTS, OBLIGATIONS AND LIABILITIES OF THE PARTIES WITH RESPECT TO THE CONTENT AND USE OF THIS DOCUMENT.  
FILE PATHWAY: X:\9.0 Engineering\9.5.2 Elec. Dwg's\01. Pkg.1 - P30255\03. Earth\Shah\P30255-29-01-59-1632 - EL See-7A CDS\Rev. A\04. Native File\P30255-29-01-59-1632-6.dwg

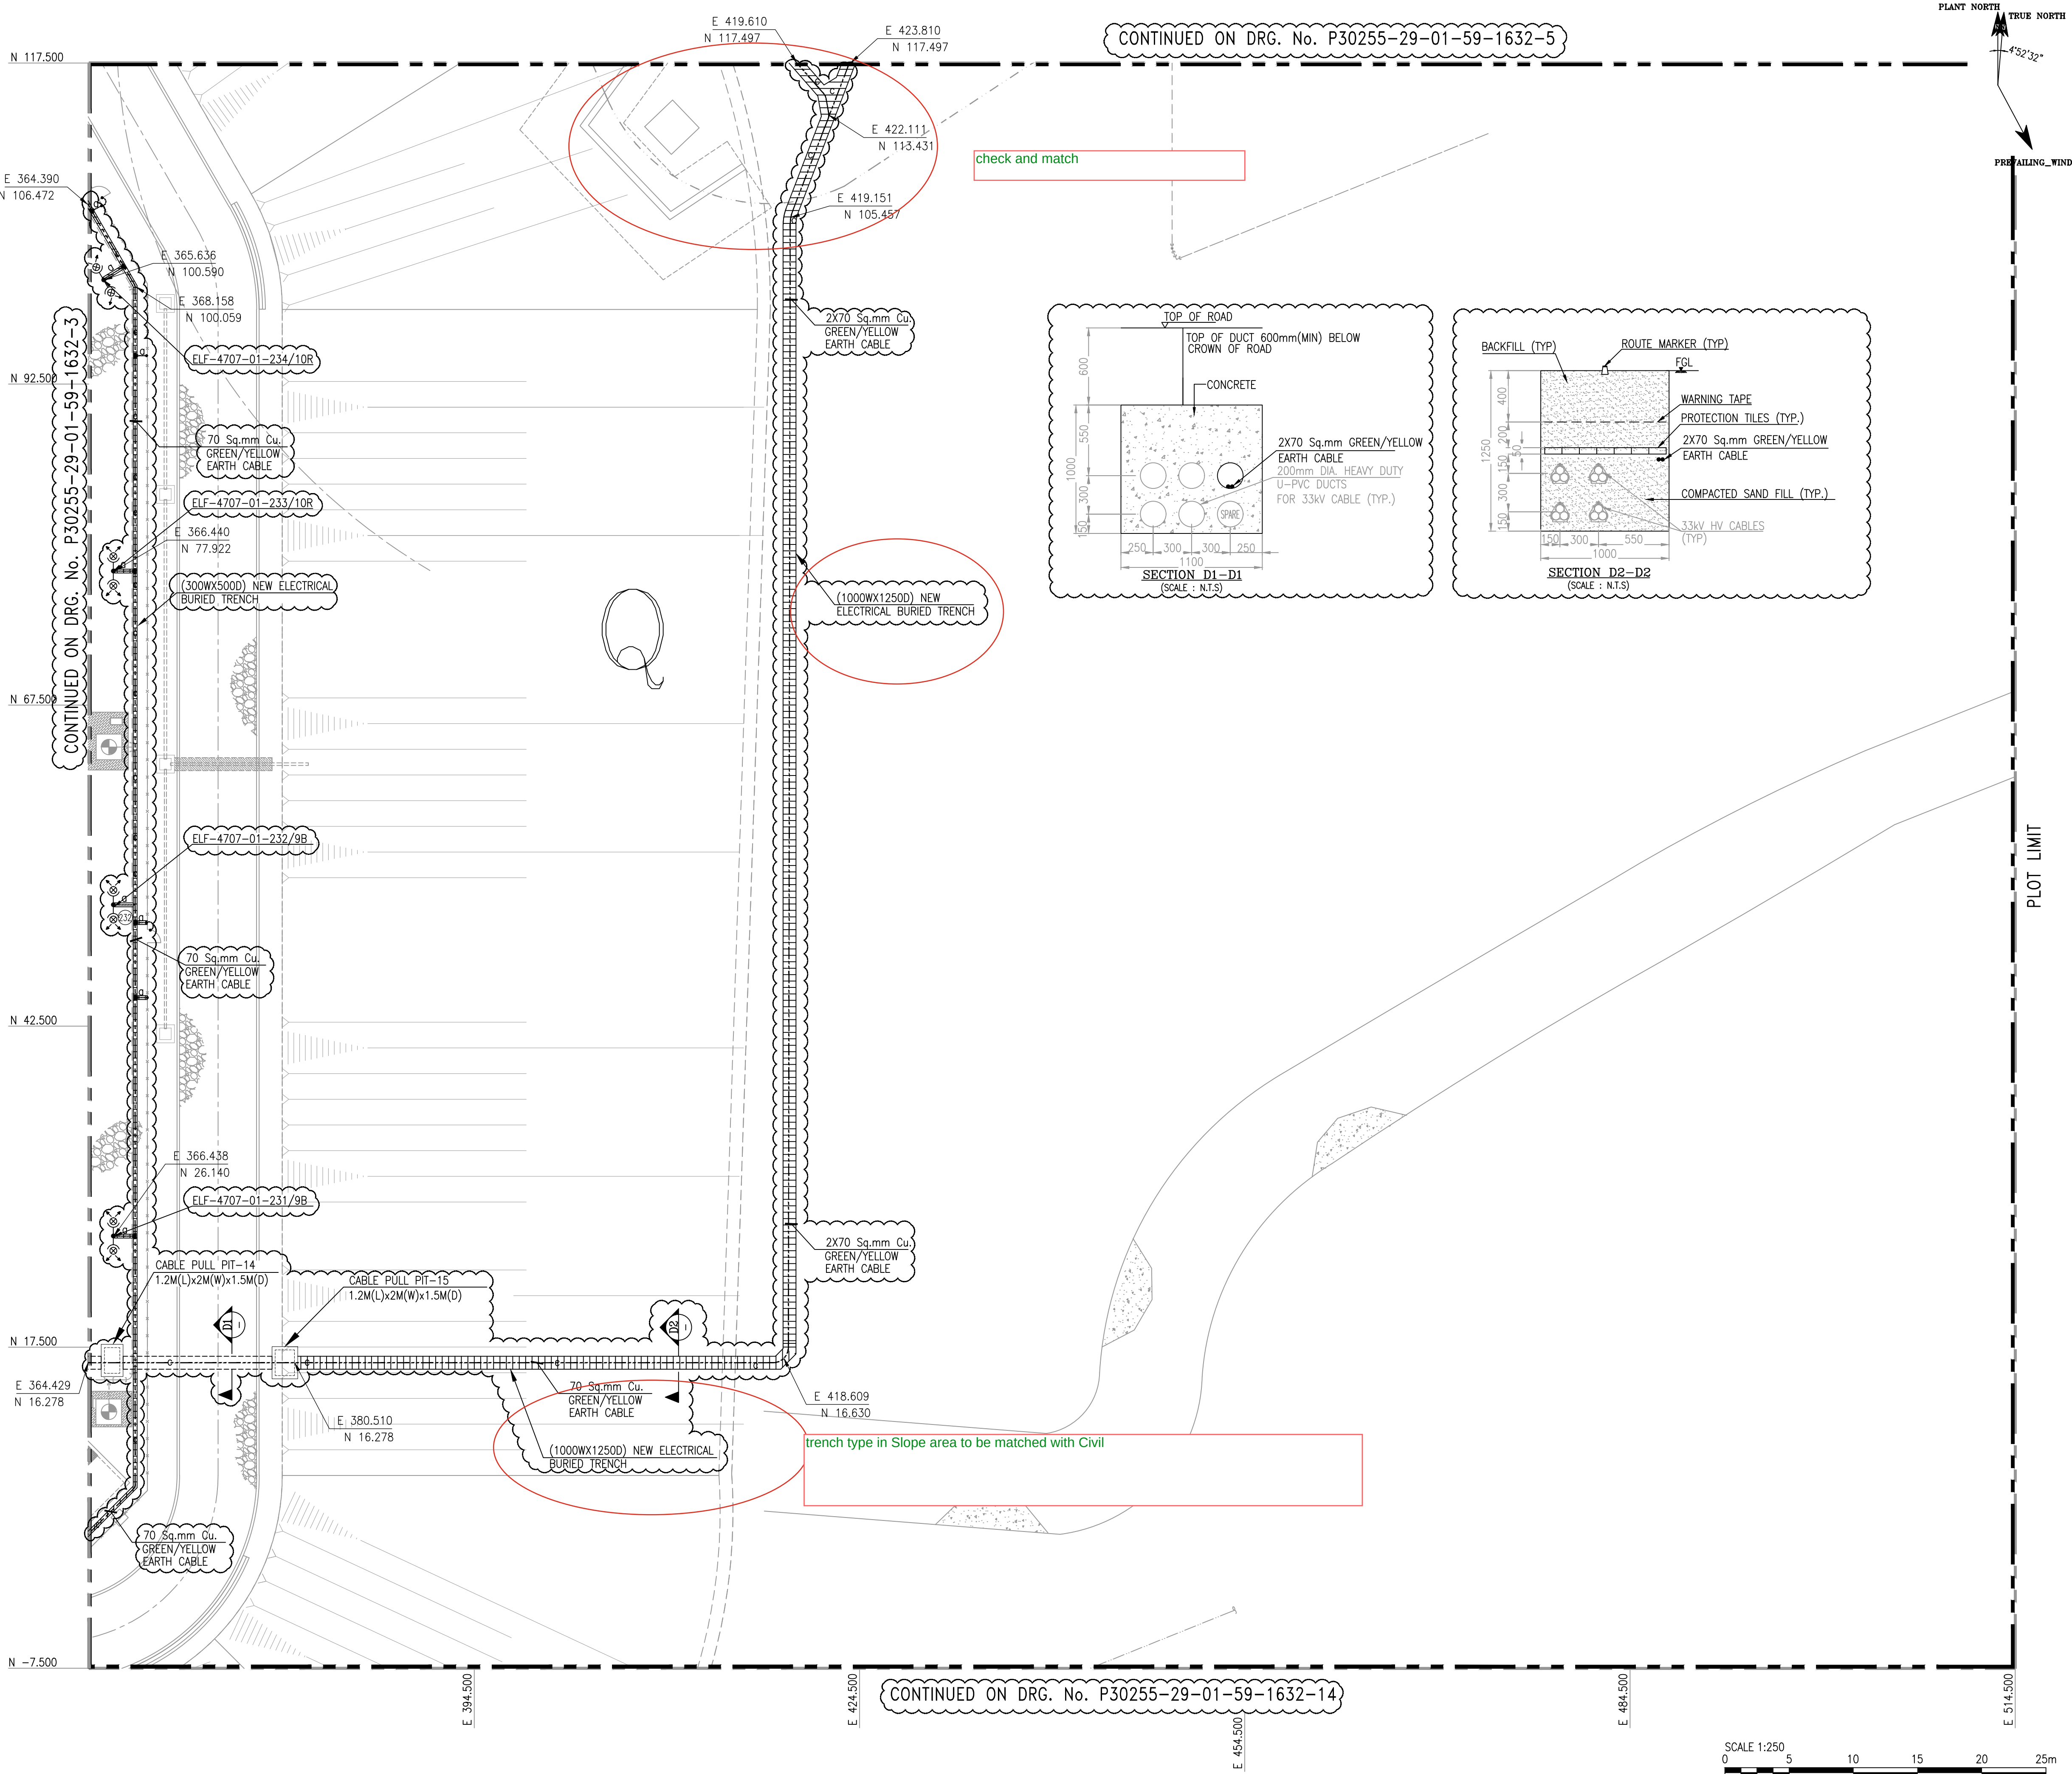

**NOTES**  
1. ALL DIMENSIONS ARE IN MILLIMETERS AND CO-ORDINATES ARE IN METERS UNLESS OTHERWISE NOTED.  
2. FOR GENERAL NOTES, LEGENDS & REFERENCE DRAWINGS REFER SHEET 1 OF THIS DRAWING.

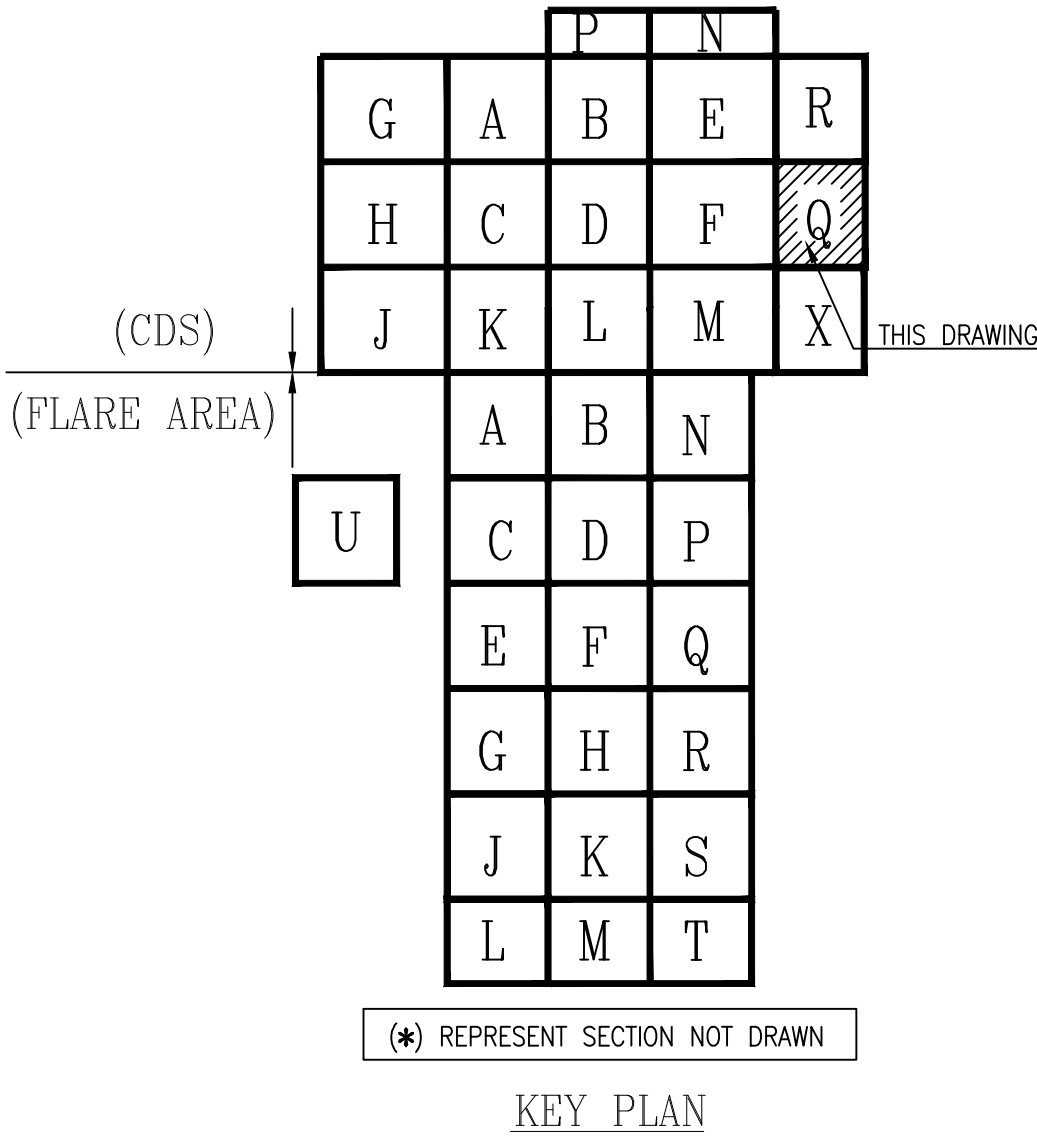

CLOUDED PORTION DENOTES :  
THE SCOPE OF WORK UNDER THE PROJECT NO. P30255

THIS DRAWING IS DEVELOPED FROM FEED DRAWING NO.  
P30255-29-01-59-0606-2 REV.1 SHT. 1/5 (P30255)

|      |            |       |       |       |                   |
|------|------------|-------|-------|-------|-------------------|
| REV. | DATE       | DR'N. | CH'D. | AP'D. | DESCRIPTION       |
| A    | 28/11/2025 | JS    | SG    | RPK   | ISSUED FOR REVIEW |

SCALE: 1:250      LOCATION: SHAH      PROJECT No. P30255

**أدنوك البرية**  
**ADNOC Onshore**

CONSULTANT / CONTRACTOR / VENDOR

**ROBT STONE** (ME) LLC  
P.O. Box: 39588  
Abu Dhabi, UAE


DRAWING No.

PROJECT: REPLACEMENT OF AGED ELECTRICAL EQUIPMENT  
AT SE FIELD

DRG. TITLE:  
**EXTERNAL ELECTRICAL EARTHING LAYOUT**  
**33kV SUBSTATION (INSTALLATION)**  
**SHAH : CDS**

|         |            |           |            |
|---------|------------|-----------|------------|
| DRG.No. | 2901591632 | A         | 6/14       |
| AREA    | P/AREA     | DOC. CODE | SERIAL No. |
| REV.    | SHT        | OF        | SHT        |

CDP\RIGHT © 2020 ALL RIGHTS RESERVED. THIS DOCUMENT IS ISSUED IN ACCORDANCE WITH AN AGREEMENT BETWEEN ROBT STONE AND IT'S CLIENTS, WHICH SETS OUT THE ENTIRE RIGHTS, OBLIGATIONS AND LIABILITIES OF THE PARTIES WITH RESPECT TO THE CONTENT AND USE OF THIS DOCUMENT.  
FILE PATHWAY: X:\9.0 Engineering\9.5 Electrical\9.5.2 Elec. Dwg's\01. Pkg.1 - P30255\03. Earth\L\Shoh\30255-29-01-59-1632 - EL Sec-7A CDS\Rev. A\04. Native File\30255-29-01-59-1632-7.dwg

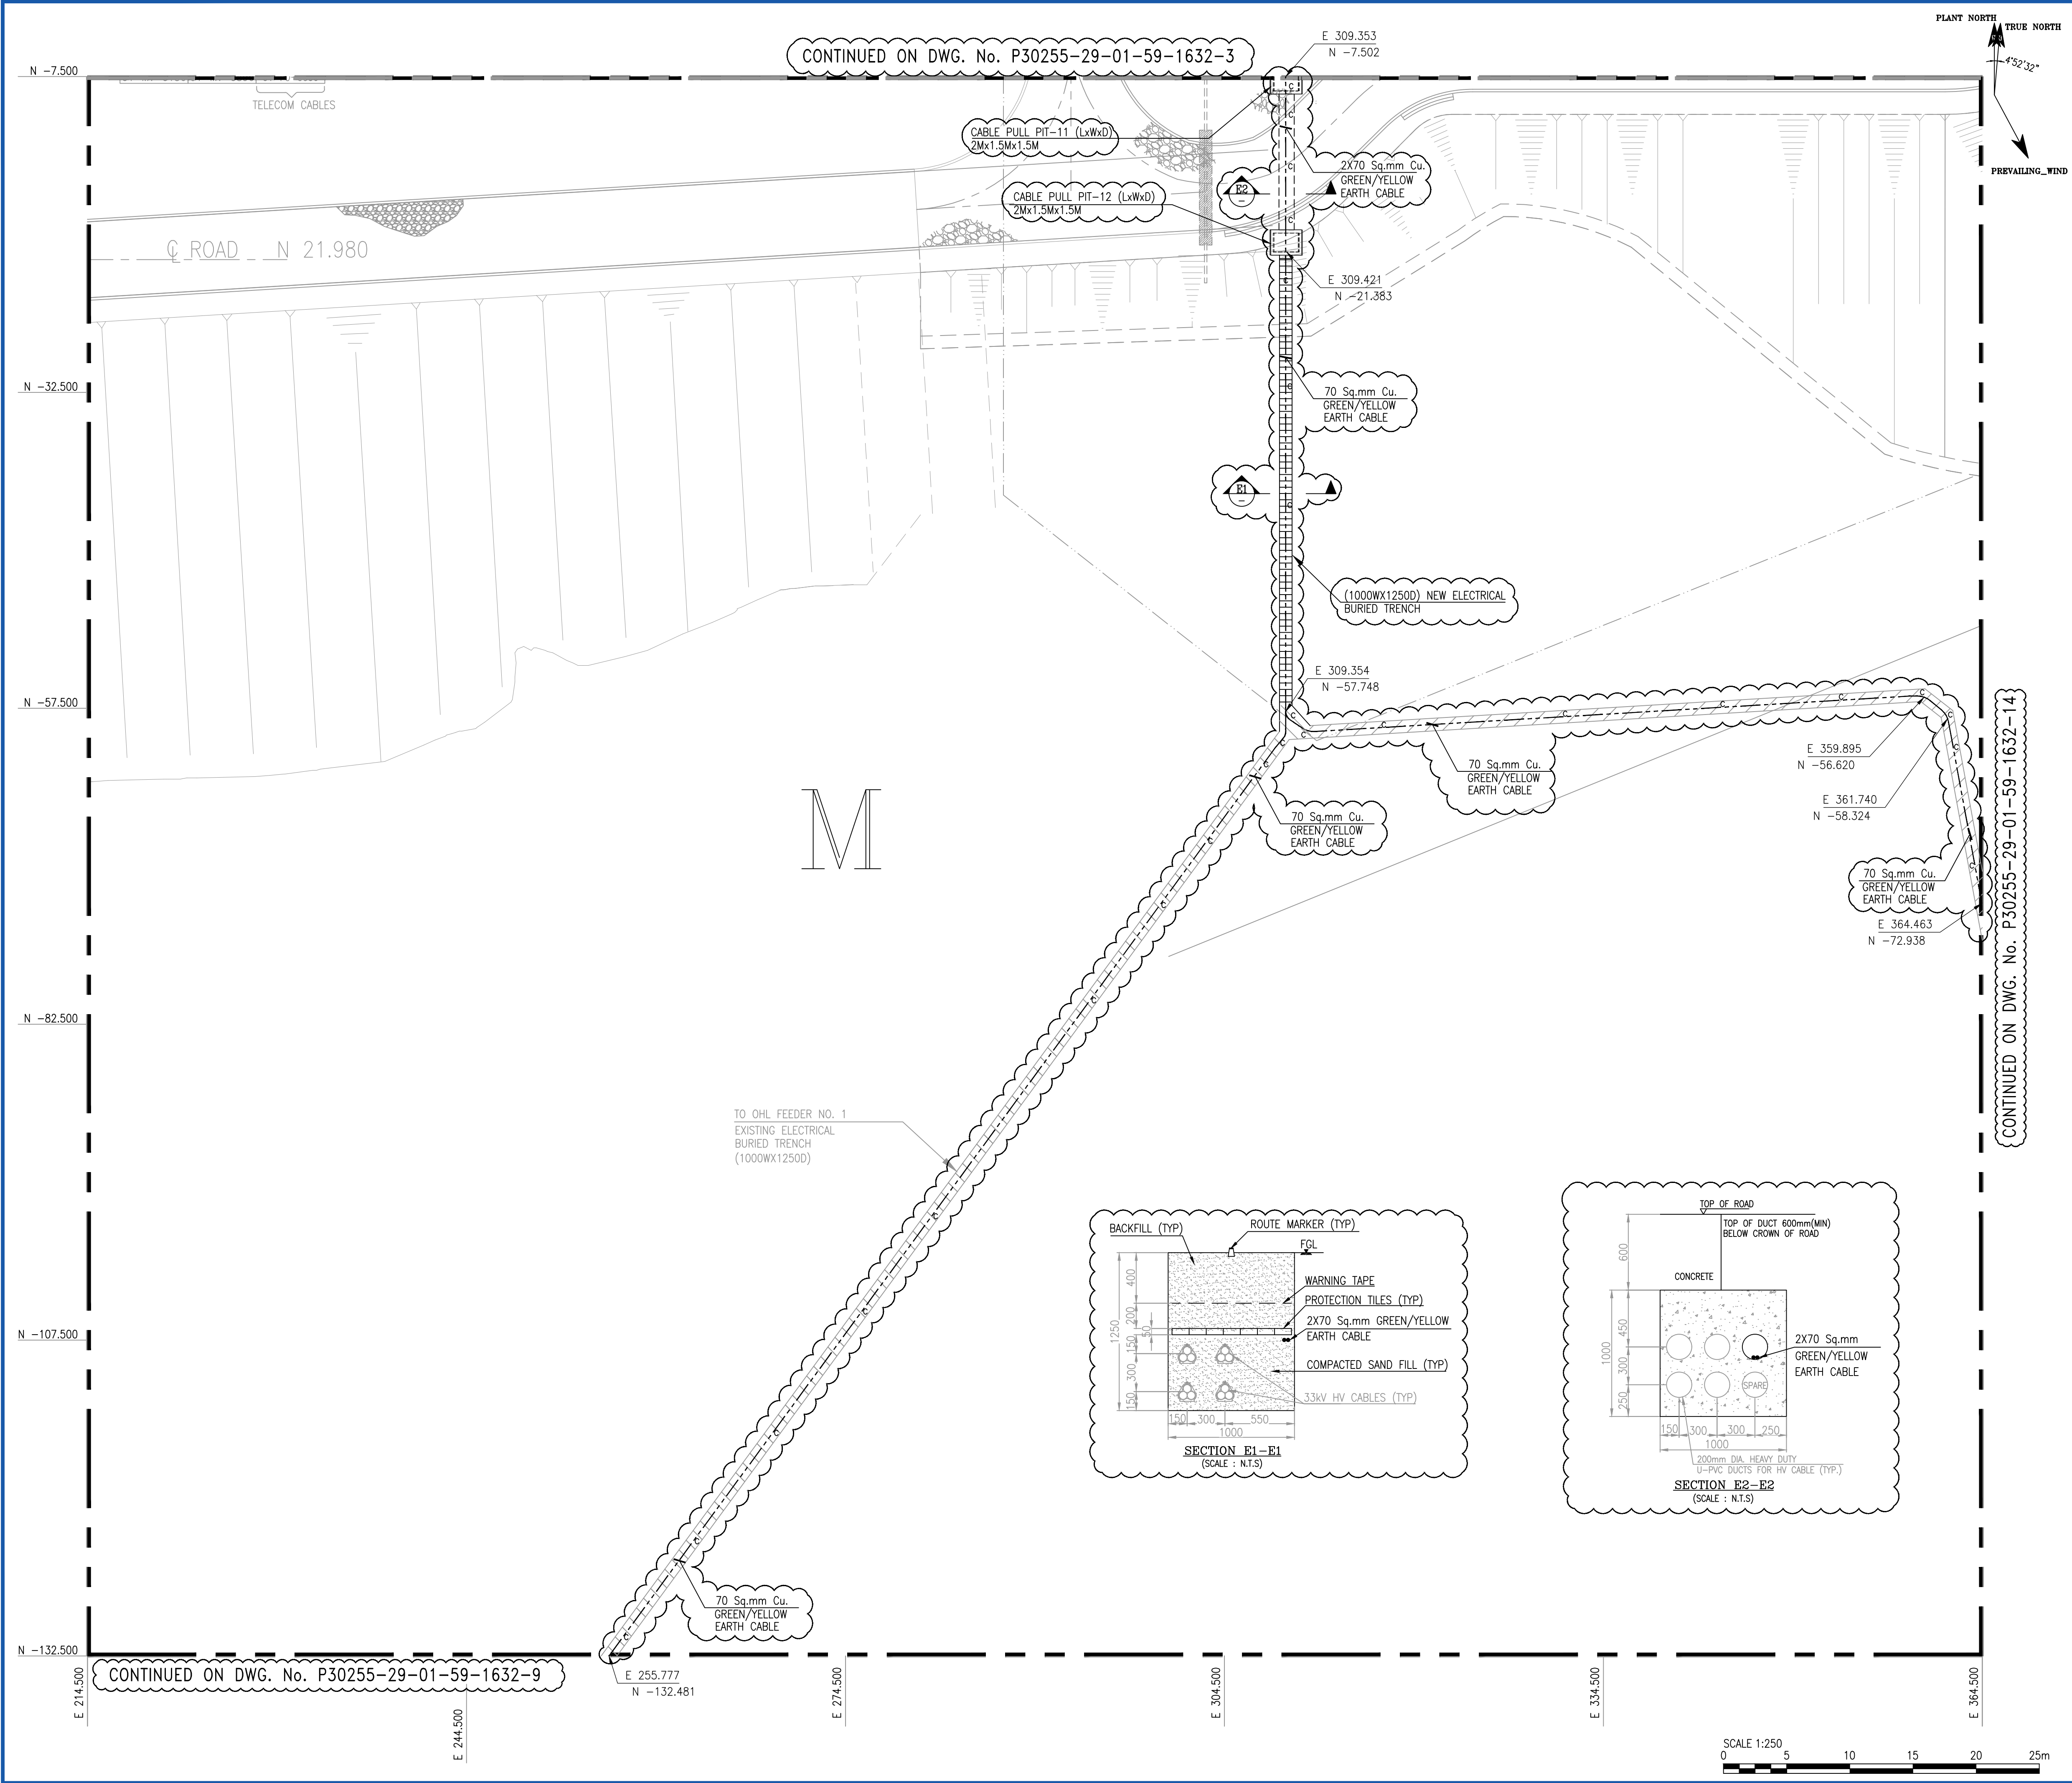

NOTES

1. ALL DIMENSIONS ARE IN MILLIMETERS AND CO-ORDINATES ARE IN METERS UNLESS OTHERWISE NOTED.

2. FOR GENERAL NOTES, LEGENDS & REFERENCE DRAWINGS REFER SHEET 1 OF THIS DRAWING.

PLANT NORTH

TRUE NORTH

4°52'32"

PREVAILING\_WIND

(CDS)

(FLARE AREA)

THIS DRAWING

(\*) REPRESENT SECTION NOT DRAWN

KEY PLAN

CLOUDED PORTION DENOTES THE SCOPE UNDER PROJECT NO. P30255

|                                                                                                                         |            |                                                          |            |                    |                   |
|-------------------------------------------------------------------------------------------------------------------------|------------|----------------------------------------------------------|------------|--------------------|-------------------|
|                                                                                                                         |            |                                                          |            |                    |                   |
| A                                                                                                                       | 28/11/2025 | JS                                                       | SG         | RPK                | ISSUED FOR REVIEW |
| REV.                                                                                                                    | DATE       | DR'N.                                                    | CH'D.      | AP'D.              | DESCRIPTION       |
| SCALE: 1:250                                                                                                            |            | LOCATION: SHAH                                           |            | PROJECT No. P30255 |                   |
|                                                                                                                         |            | <b>أدنوك البرية</b><br><b>ADNOC Onshore</b>              |            |                    |                   |
| CONSULTANT / CONTRACTOR / VENDOR                                                                                        |            | ROBT STONE (ME) LLC<br>P.O. Box: 39588<br>Abu Dhabi, UAE |            |                    |                   |
| DRAWING No.                                                                                                             |            |                                                          |            |                    |                   |
| PROJECT: REPLACEMENT OF AGED ELECTRICAL EQUIPMENT<br>AT SE FIELD                                                        |            |                                                          |            |                    |                   |
| DRG. TITLE:<br><b>EXTERNAL ELECTRICAL EARTHING LAYOUT</b><br><b>33kV SUBSTATION (INSTALLATION)</b><br><b>SHAH : CDS</b> |            |                                                          |            |                    |                   |
| DRG.No.                                                                                                                 | 2901591632 | A                                                        | 7/14       |                    |                   |
| AREA                                                                                                                    | P/AREA     | DOC. CODE                                                | SERIAL No. | REV.               | SHT OF SHT        |


FORM\_ADNOC\_Onshore\_A1.dwg\_(REV.2)

2017 ADNOC Onshore . All rights reserved. Abu Dhabi Company for Onshore Petroleum Operations Ltd. Restricted Circulation

P30255-29-01-59-1632-7.DWG

COPYRIGHT © 2020. ALL RIGHTS RESERVED. THIS DOCUMENT IS ISSUED IN ACCORDANCE WITH AN AGREEMENT BETWEEN ROBT STONE AND ITS CLIENTS, WHICH SETS OUT THE ENTIRE RIGHTS, OBLIGATIONS AND LIABILITIES OF THE PARTIES WITH RESPECT TO THE CONTENT AND USE OF THIS DOCUMENT.  
FILE PATHWAY: X:\9.0 Engineering\9.5 Electrical\9.5.2 Elec. Dwg's\01. Plg.1 - P30255\03. Earth\Shah\P30255-29-01-59-1632 - EL Sec-7A CDS\Rev. A\04. Native File\P30255-29-01-59-1632-8.dwg

FORM ADNOC\_Onshore\_A0.dwg\_(REV.2)

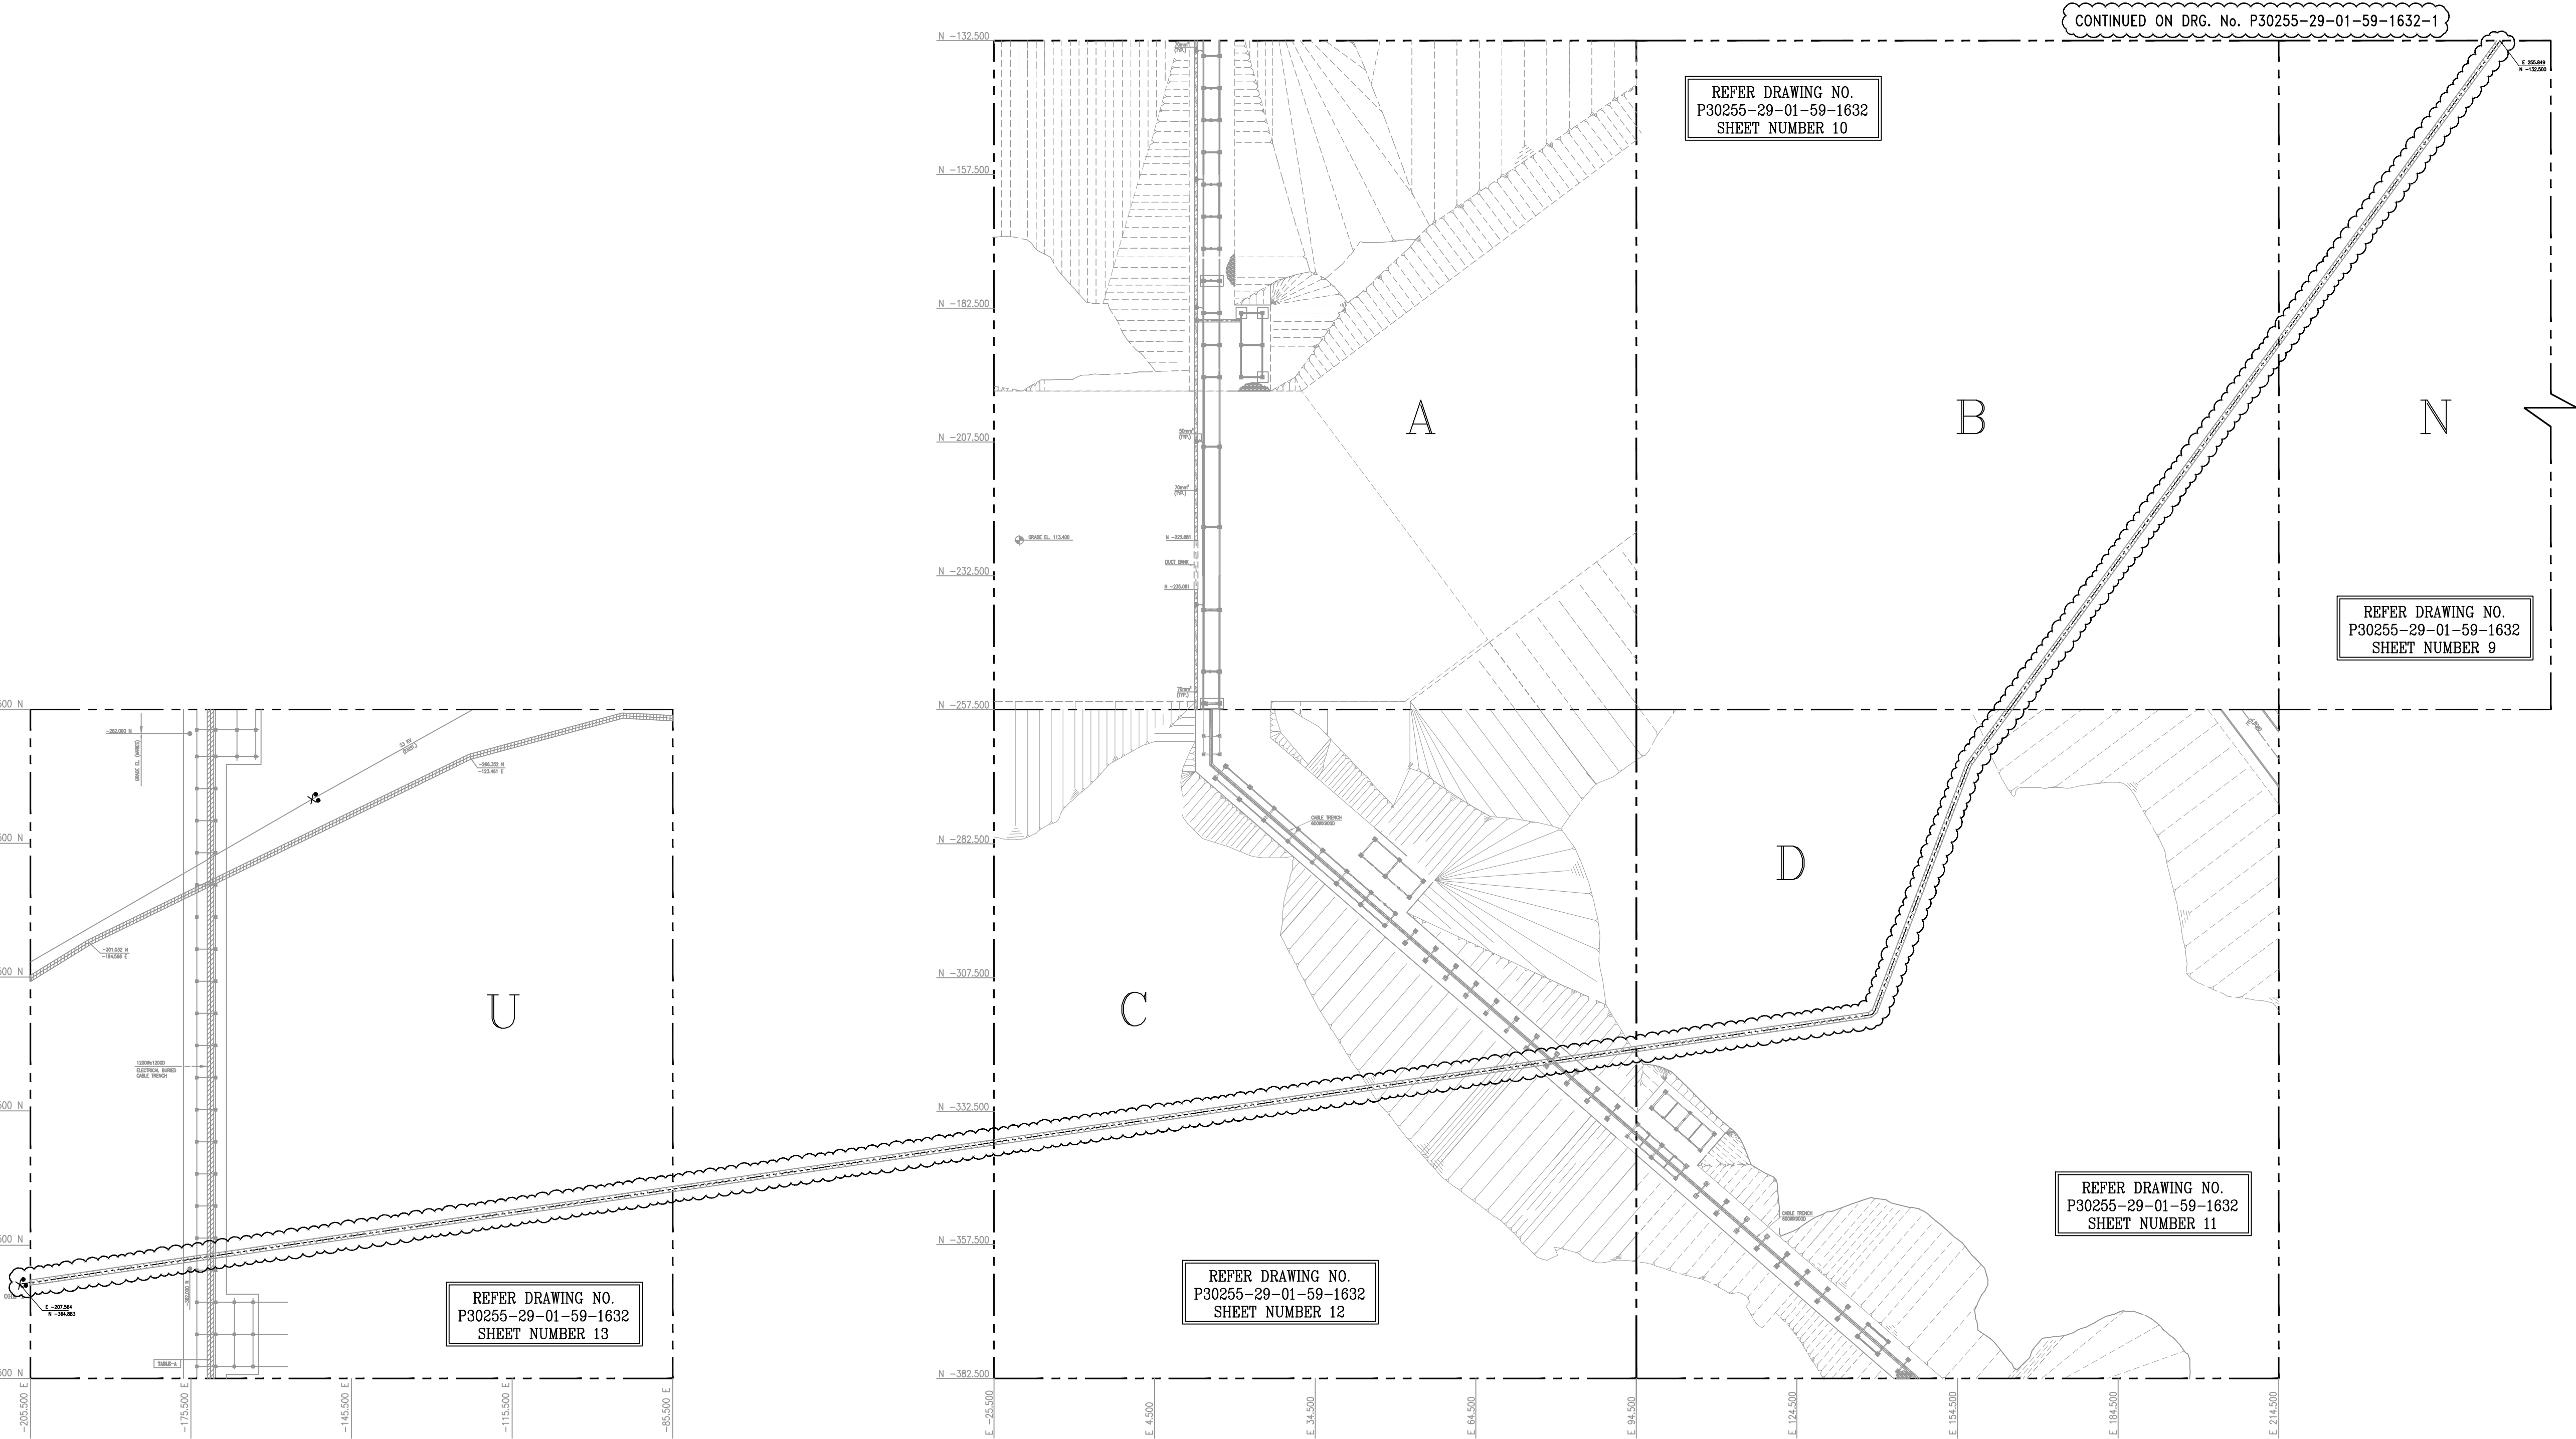

NOTES

1. ALL DIMENSIONS ARE IN MILLIMETERS AND CO-ORDINATES ARE IN METERS UNLESS OTHERWISE NOTED.

2. FOR GENERAL NOTES, LEGENDS & REFERENCE DRAWINGS REFER SHEET 1 OF THIS DRAWING.

PLANT NORTH

TRUE NORTH

4°52'32"

PREVAILING\_WIND

CONTINUED ON DRG. No. P30255-29-01-59-1632-1

REFER DRAWING NO.  
P30255-29-01-59-1632  
SHEET NUMBER 10

REFER DRAWING NO.  
P30255-29-01-59-1632  
SHEET NUMBER 9

REFER DRAWING NO.  
P30255-29-01-59-1632  
SHEET NUMBER 11

REFER DRAWING NO.  
P30255-29-01-59-1632  
SHEET NUMBER 12

REFER DRAWING NO.  
P30255-29-01-59-1632  
SHEET NUMBER 13

(CDS)

(FLARE AREA)

U

A

B

C

D

E

F

G

H

J

K

L

M

N

P

Q

R

S

T

X

THIS DRAWING



(\*) REPRESENT SECTION NOT DRAWN

KEY PLAN


CLOUDED PORTION DENOTES  
THE SCOPE UNDER PROJECT NO. P30255

|                                                                                                                                                                                                                                                                                                           |            |                |            |                    |                   |
|-----------------------------------------------------------------------------------------------------------------------------------------------------------------------------------------------------------------------------------------------------------------------------------------------------------|------------|----------------|------------|--------------------|-------------------|
|                                                                                                                                                                                                                                                                                                           |            |                |            |                    |                   |
| A                                                                                                                                                                                                                                                                                                         | 28/11/2025 | JS             | SG         | RPK                | ISSUED FOR REVIEW |
| REV.                                                                                                                                                                                                                                                                                                      | DATE       | DR'N.          | CH'D.      | AP'D.              | DESCRIPTION       |
| SCALE: 1:500                                                                                                                                                                                                                                                                                              |            | LOCATION: SHAH |            | PROJECT No. P30255 |                   |
| <div><div><div><div>ADNOC</div><div>أدنوك البرية</div></div><div><div>ADNOC Onshore</div><div>أدنوك البرية</div></div></div><div><div>CONSULTANT / CONTRACTOR / VENDOR</div><div><div>ROBT STONE</div><div>ROBT STONE (ME) LLC</div><div>P.O. Box: 30588</div><div>Abu Dhabi, UAE</div></div></div></div> |            |                |            |                    |                   |
| DRAWING No.                                                                                                                                                                                                                                                                                               |            |                |            |                    |                   |
| PROJECT: REPLACEMENT OF AGED ELECTRICAL EQUIPMENT<br>AT SE FIELD                                                                                                                                                                                                                                          |            |                |            |                    |                   |
| DRG. TITLE:<br>EXTERNAL ELECTRICAL EARTHING LAYOUT<br>33kV SUBSTATION (INSTALLATION)<br>SHAH : CDS                                                                                                                                                                                                        |            |                |            |                    |                   |
| DRG. No.                                                                                                                                                                                                                                                                                                  | 2901591632 | A              | 8/14       |                    |                   |
| AREA                                                                                                                                                                                                                                                                                                      | P/AREA     | DOC. CODE      | SERIAL No. | REV.               | SHT OF SHT        |

COPYRIGHT © 2020 ALL RIGHTS RESERVED. THIS DOCUMENT IS ISSUED IN ACCORDANCE WITH AN AGREEMENT BETWEEN ROBT STONE AND IT'S CLIENTS, WHICH SETS OUT THE ENTIRE RIGHTS, OBLIGATIONS AND LIABILITIES OF THE PARTIES WITH RESPECT TO THE CONTENT AND USE OF THIS DOCUMENT.  
FILE PATHWAY: X:\9.0 Engineering\9.5.2 Elec. Dwg's\01. Pkg.1 - P30255\03. Electrical\Shah\Shah\30255-29-01-59-1632 - El. Sec-7A CDS\Rev. A\04. Native File\30255-29-01-59-1632-9.dwg

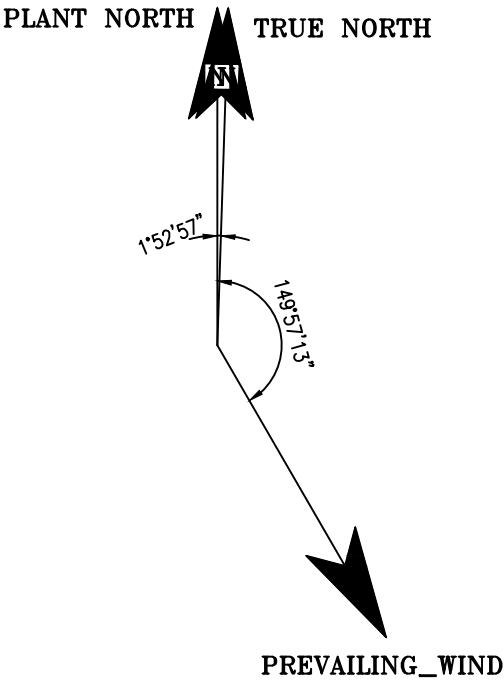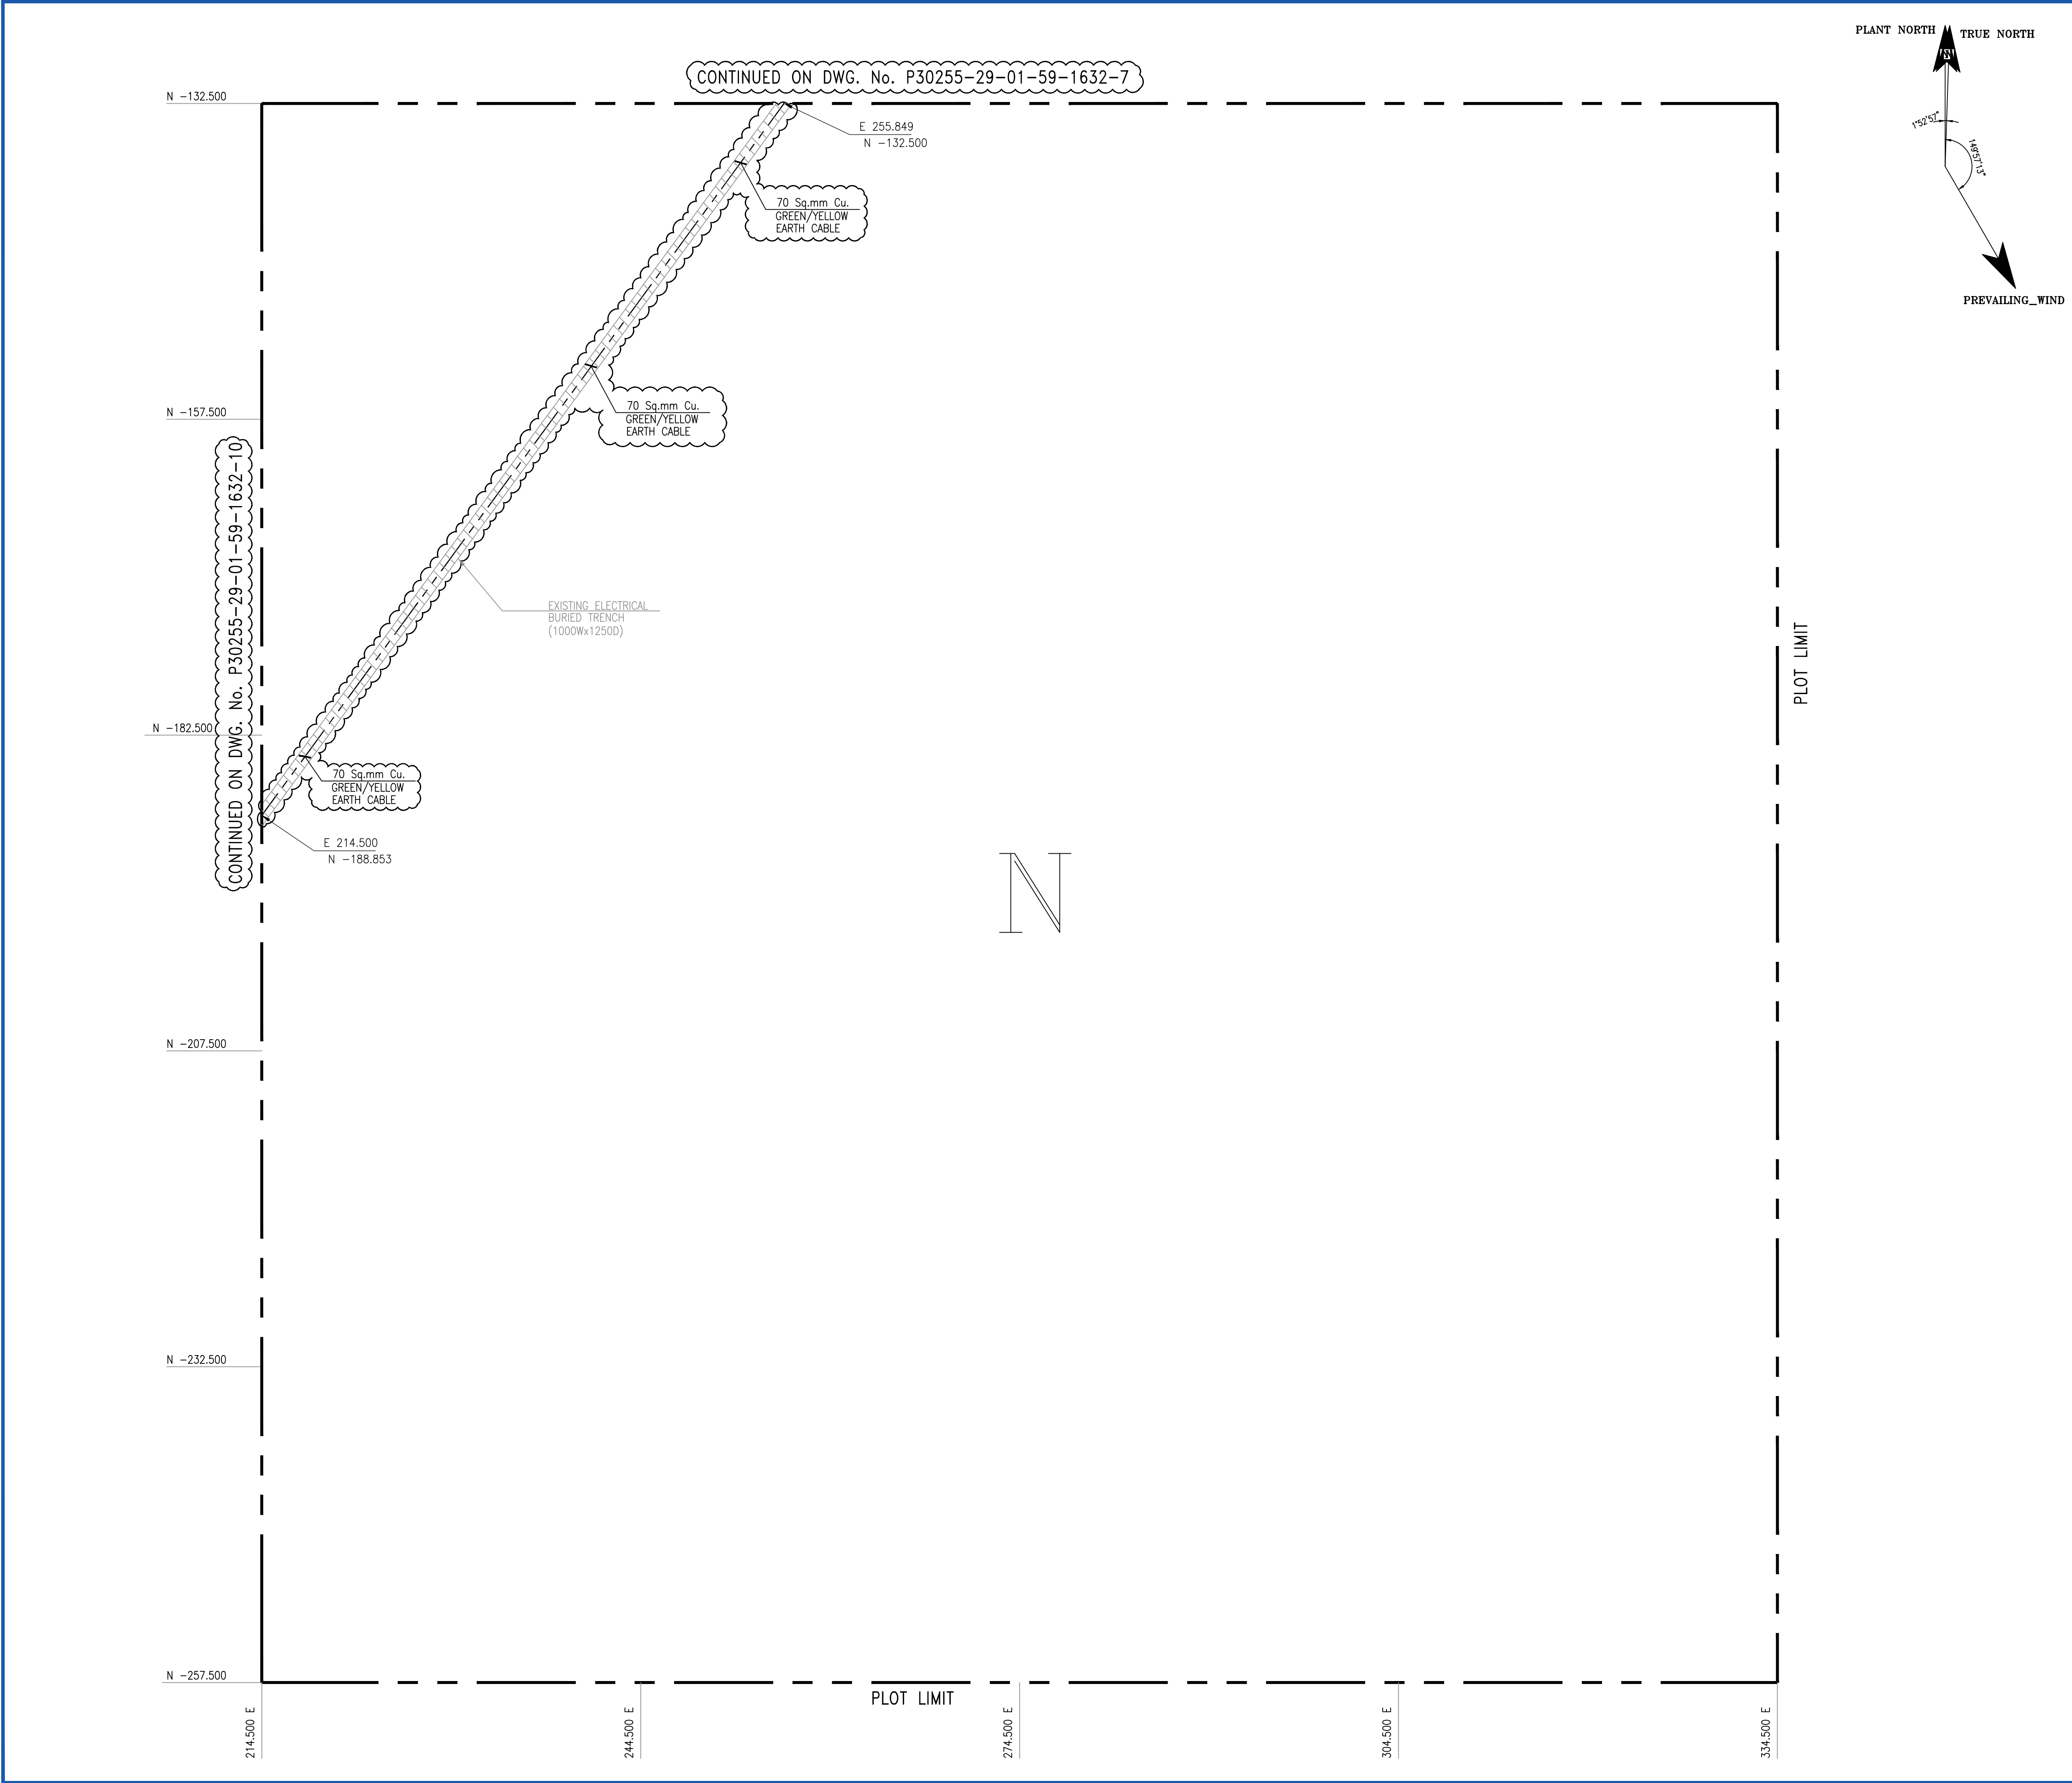

- NOTES
1. ALL DIMENSIONS ARE IN MILLIMETERS AND CO-ORDINATES ARE IN METERS UNLESS OTHERWISE NOTED.
  2. FOR GENERAL NOTES, LEGENDS & REFERENCE DRAWINGS REFER SHEET 1 OF THIS DRAWING.

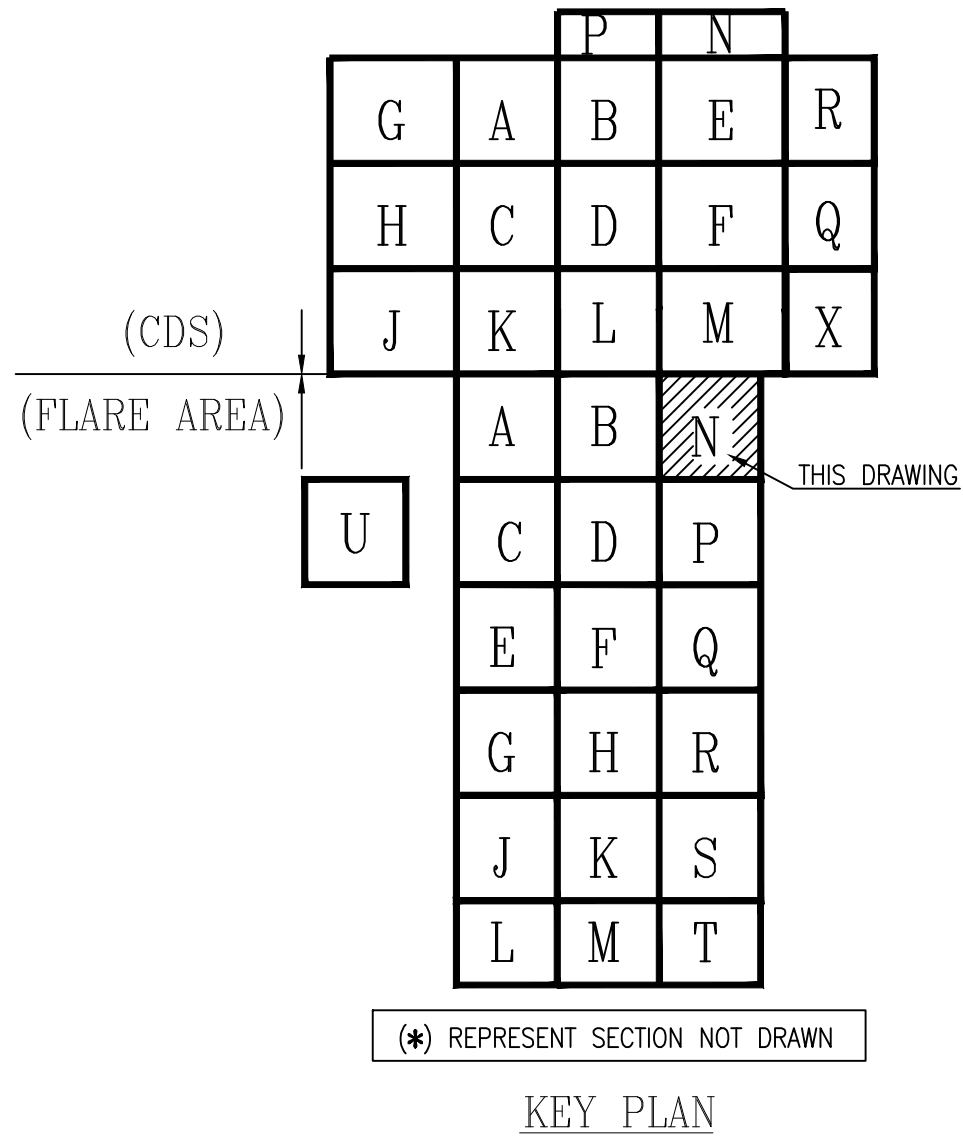

CLOUDED PORTION DENOTES :  
THE SCOPE OF WORK UNDER THE PROJECT NO. P30255

|              |            |                |       |                    |                   |
|--------------|------------|----------------|-------|--------------------|-------------------|
|              |            |                |       |                    |                   |
| A            | 28/11/2025 | JS             | SG    | RPK                | ISSUED FOR REVIEW |
| REV.         | DATE       | DR'N.          | CH'D. | AP'D.              | DESCRIPTION       |
| SCALE: 1:250 |            | LOCATION: SHAH |       | PROJECT No. P30255 |                   |



**أدنوك البرية**  
**ADNOC Onshore**

CONSULTANT / CONTRACTOR / VENDOR



ROBT STONE (ME) LLC  
P.O. Box: 39588  
Abu Dhabi, U.A.E


DRAWING No.

PROJECT: REPLACEMENT OF AGED ELECTRICAL EQUIPMENT  
AT SE FIELD

DRG. TITLE:  
**EXTERNAL ELECTRICAL EARTHING LAYOUT**  
**33kV SUBSTATION (INSTALLATION)**  
**SHAH : CDS**

|         |            |           |            |
|---------|------------|-----------|------------|
| DRG.No. | 2901591632 | A         | 9/14       |
| AREA    | P/AREA     | DOC. CODE | SERIAL No. |
| REV.    | SHT        | OF        | SHT        |

FORM\_ADNOC\_Onshore\_A1.dwg\_(REV.2)

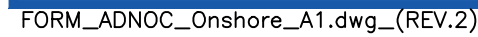

PREVAILING\_WIND

1. ALL DIMENSIONS ARE IN MILLIMETERS AND CO-ORDINATES ARE IN METERS UNLESS OTHERWISE NOTED.
2. FOR GENERAL NOTES, LEGENDS & REFERENCE DRAWINGS REFER SHEET 1 OF THIS DRAWING.

1. ALL DIMENSIONS ARE IN MILLIMETERS AND CO-ORDINATES ARE IN METERS UNLESS OTHERWISE NOTED.
2. FOR GENERAL NOTES, LEGENDS & REFERENCE DRAWINGS REFER SHEET 1 OF THIS DRAWING.



THE SCOPE OF WORK UNDER THE PROJECT NO. P30255

|              |                |                    |
|--------------|----------------|--------------------|
| SCALE: 1:250 | LOCATION: SHAH | PROJECT No. P30255 |
|--------------|----------------|--------------------|




**ROBT STONE (ME) LLC**  
P.O. Box. 39588  
Abu Dhabi, U.A.E

REPORT NUMBER OF LOGS SUBMITTED TO AGENCY

DRG. TITLE: EXTERNAL ELECTRICAL FIBERING LIGHT

SHAH · CDS

| AREA | P/AREA | DOC. CODE | SERIAL No. | REV. | SHT | OF | SHT |
|------|--------|-----------|------------|------|-----|----|-----|
|------|--------|-----------|------------|------|-----|----|-----|

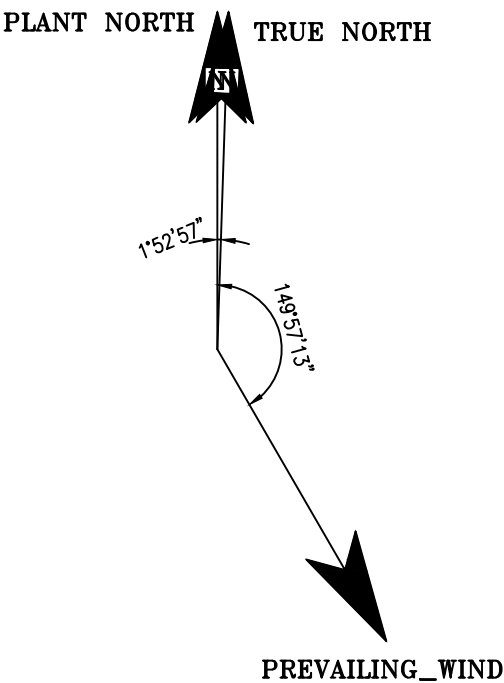

1. ALL DIMENSIONS ARE IN MILLIMETERS AND CO-ORDINATES ARE IN METERS UNLESS OTHERWISE NOTED.
2. FOR GENERAL NOTES, LEGENDS & REFERENCE DRAWINGS REFER SHEET 1 OF THIS DRAWING.



THIS DRAWING IS DEVELOPED FROM MASTER DRAWING NO.  
29-39-59-0114-1 REV.1 SHT. 1/1 (P30255)

|              |            |                |                                                                                       |                                                                                       |                    |
|--------------|------------|----------------|---------------------------------------------------------------------------------------|---------------------------------------------------------------------------------------|--------------------|
|              |            |                |                                                                                       |                                                                                       |                    |
|              |            | #344444        |  |  |                    |
| A            | 28/11/2025 | JS             | SG                                                                                    | RPK                                                                                   | ISSUED FOR REVIEW  |
| REV.         | DATE       | DR'N.          | CH'D.                                                                                 | AP'D.                                                                                 | DESCRIPTION        |
| SCALE: 1:250 |            | LOCATION: SHAH |                                                                                       |                                                                                       | PROJECT No. P30255 |



**أدنوك البرية**  
**ADNOC Onshore**

~~CONSULTANT~~ / CONTRACTOR / ~~VENDOR~~

ROBT STONE (ME) LLC  
P.O. Box. 39588  
Abu Dhabi, U.A.E

DRAWING No.

PROJECT: REPLACEMENT OF AGED ELECTRICAL EQUIPMENT  
AT SE FIELD

DRG. TITLE: EXTERNAL ELECTRICAL EARTHING LAYOUT  
33kV SUBSTATION (INSTALLATION)  
SHAH : CDS

|         |            |           |            |
|---------|------------|-----------|------------|
| DRG.No. | 2901591632 | A         | 11/14      |
| AREA    | P/AREA     | DOC. CODE | SHT OF SHT |



KEY PLAN

1. ALL DIMENSIONS ARE IN MILLIMETERS AND CO-ORDINATES ARE IN METERS UNLESS OTHERWISE NOTED.
2. FOR GENERAL NOTES, LEGENDS & REFERENCE DRAWINGS REFER SHEET 1 OF THIS DRAWING.

THIS DRAWING IS DEVELOPED FROM MASTER DRAWING NO.  
29-39-59-0013-1 REV.1 SHT. 1/1

|              |                |                    |
|--------------|----------------|--------------------|
| SCALE: 1:250 | LOCATION: SHAH | PROJECT No. P30255 |
|--------------|----------------|--------------------|





**ROBT STONE** (ME) LLC  
P.O. Box. 39588  
Alto, Okla. 74002


DRG. TITLE: EXTERNAL ELECTRICAL EARTHING LAYOUT  
33kV SUBSTATION (INSTALLATION)  
SHAH : CDS

P30255-29-01-59-1632-12.DWG

COPYRIGHT © 2020 ALL RIGHTS RESERVED. THIS DOCUMENT IS ISSUED IN ACCORDANCE WITH AN AGREEMENT BETWEEN ROBT STONE AND IT'S CLIENTS, WHICH SETS OUT THE ENTIRE RIGHTS, OBLIGATIONS AND LIABILITIES OF THE PARTIES WITH RESPECT TO THE CONTENT AND USE OF THIS DOCUMENT.  
FILE PATHWAY: X:\9.0 Engineering\9.5 Electrical\9.5.2 Elec. Dwg's\01. Pkg.1 - P30255\03. Earth\Shoh\P30255-29-01-59-1632 - EL Sec-7A CDS\Rev. A\04. Native File\P30255-29-01-59-1632-13.dwg

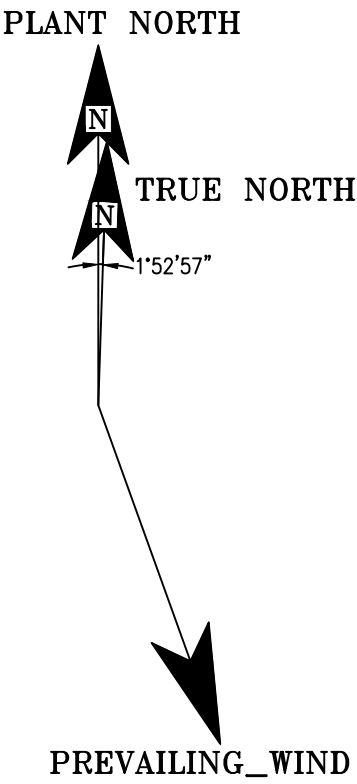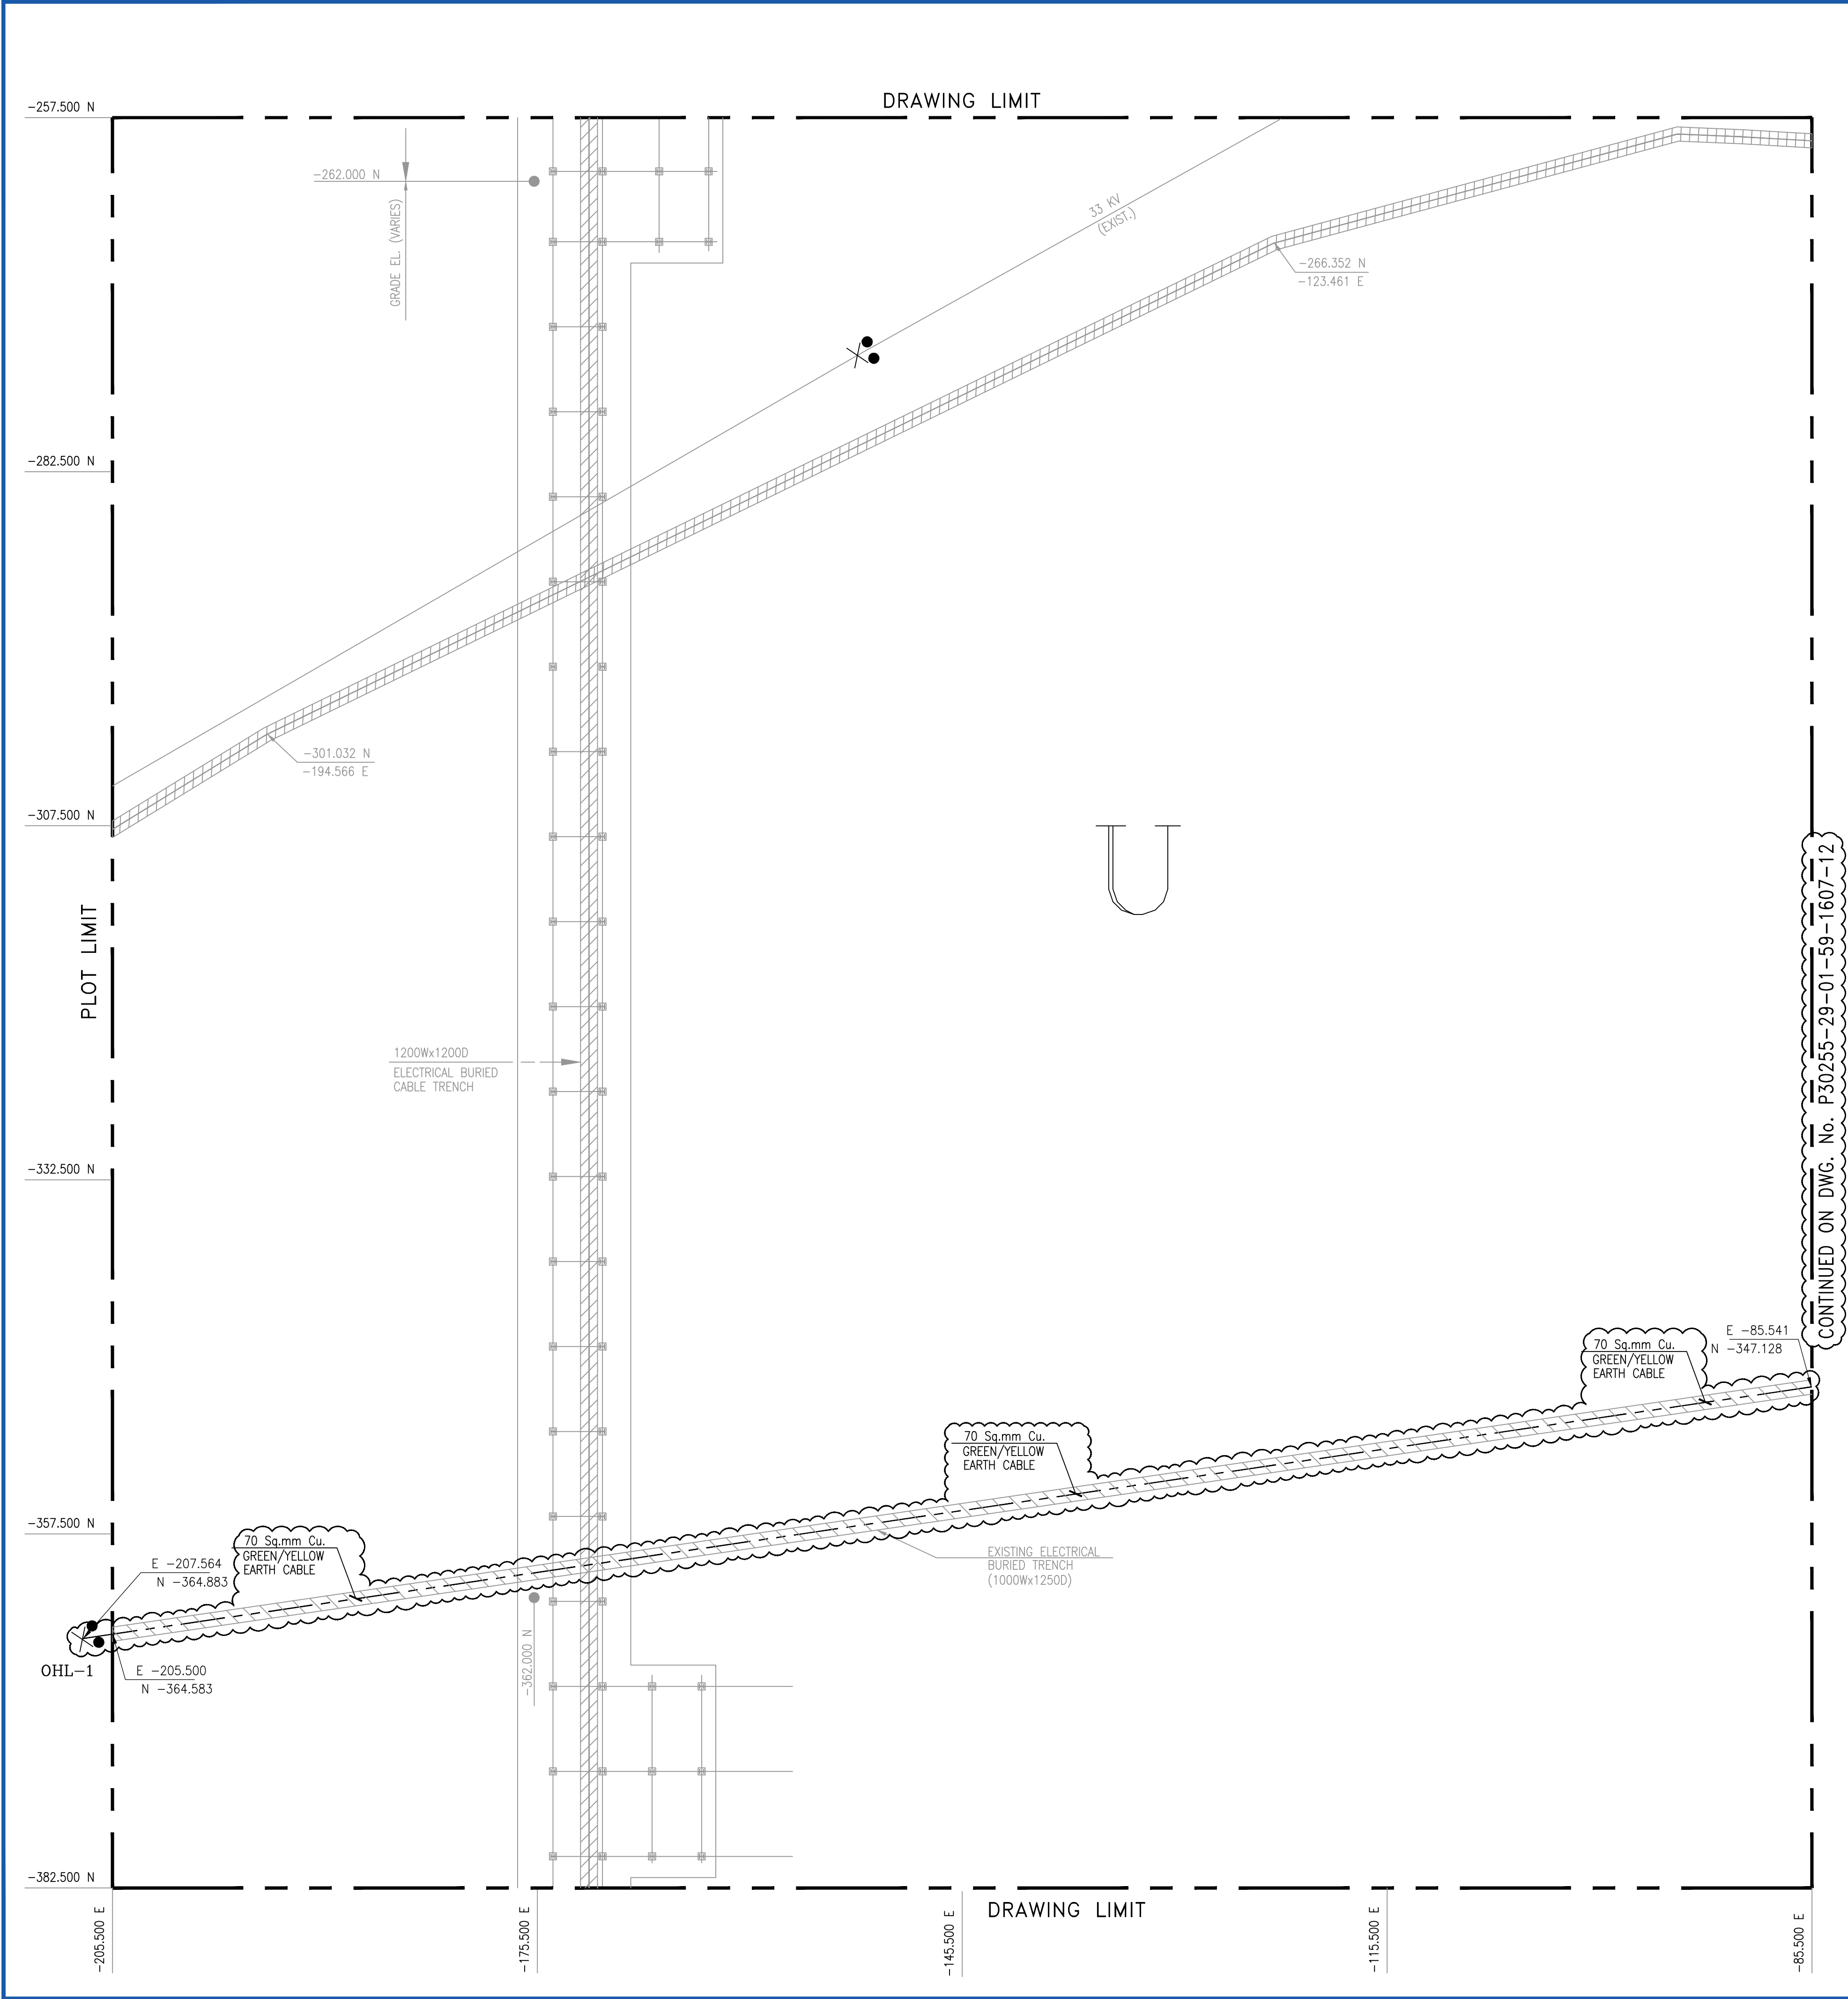



- NOTES
1. ALL DIMENSIONS ARE IN MILLIMETERS AND CO-ORDINATES ARE IN METERS UNLESS OTHERWISE NOTED.
  2. FOR GENERAL NOTES, LEGENDS & REFERENCE DRAWINGS REFER SHEET 1 OF THIS DRAWING.

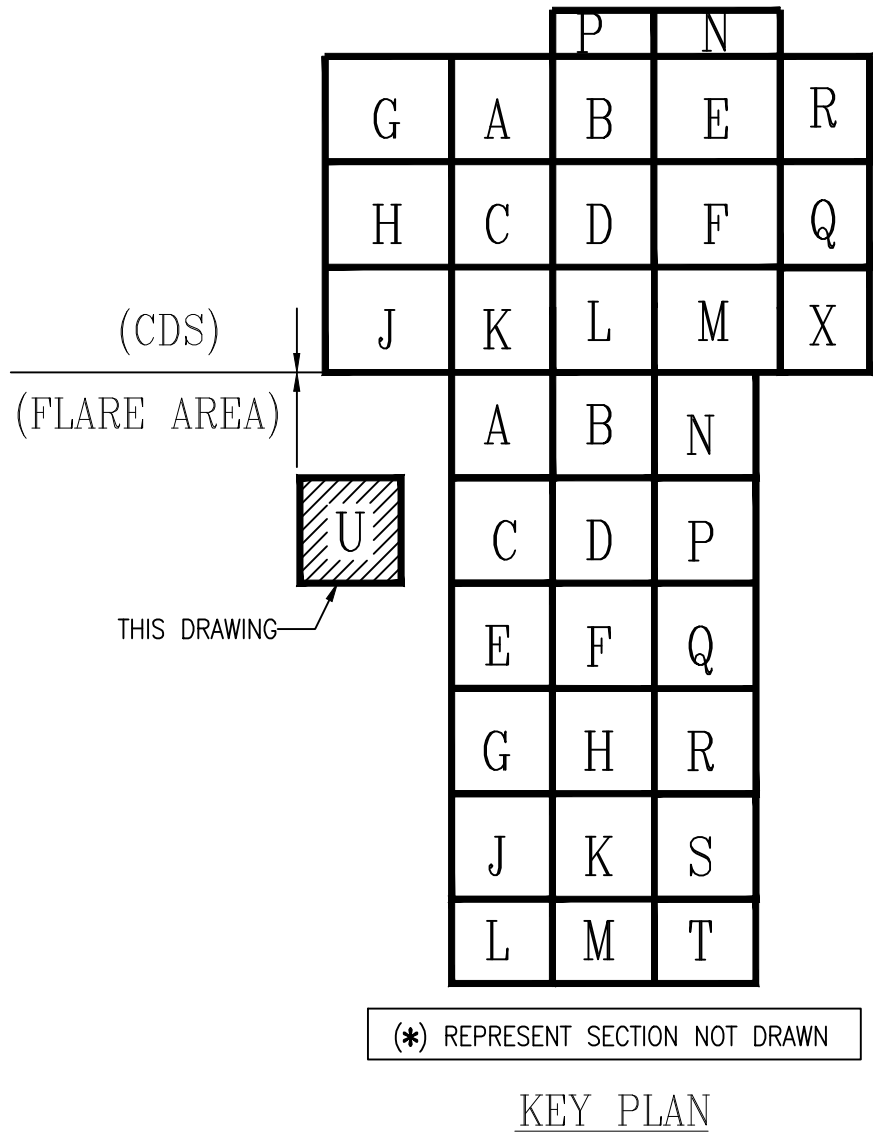


- CLOUDED PORTION DENOTES :  
THE SCOPE OF WORK UNDER THE PROJECT NO. P30255
- THIS DRAWING IS DEVELOPED FROM MASTER DRAWING NO.  
29-39-59-0129-1 REV.1 SHT. 1/1 (P30255)

|                                                                                                                                                                       |            |                |            |                                                                                                                                                                                                           |                    |
|-----------------------------------------------------------------------------------------------------------------------------------------------------------------------|------------|----------------|------------|-----------------------------------------------------------------------------------------------------------------------------------------------------------------------------------------------------------|--------------------|
|                                                                                                                                                                       |            |                |            |                                                                                                                                                                                                           |                    |
| A                                                                                                                                                                     | 28/11/2025 | JS             | SG         | RPK                                                                                                                                                                                                       | ISSUED FOR REVIEW  |
| REV.                                                                                                                                                                  | DATE       | DR'N.          | CH'D.      | AP'D.                                                                                                                                                                                                     | DESCRIPTION        |
| SCALE: 1:250                                                                                                                                                          |            | LOCATION: SHAH |            |                                                                                                                                                                                                           | PROJECT No. P30255 |
| <div><div></div><div><div>أدنوك البرية</div><div>ADNOC Onshore</div></div></div> |            |                |            |                                                                                                                                                                                                           |                    |
| CONSULTANT / CONTRACTOR / VENDOR                                                                                                                                      |            |                |            | <div><div></div><div><div>ROBT STONE (ME) LLC</div><div>P.O. Box. 39588</div><div>Abu Dhabi, U.A.E</div></div></div> |                    |
| DRAWING No.                                                                                                                                                           |            |                |            |                                                                                                                                                                                                           |                    |
| PROJECT: REPLACEMENT OF AGED ELECTRICAL EQUIPMENT<br>AT SE FIELD                                                                                                      |            |                |            |                                                                                                                                                                                                           |                    |
| DRG. TITLE:<br>EXTERNAL ELECTRICAL EARTHING LAYOUT<br>33kV SUBSTATION (INSTALLATION)<br>SHAH : CDS                                                                    |            |                |            |                                                                                                                                                                                                           |                    |
| DRG.No.                                                                                                                                                               | 2901591632 |                | A          | 13/14                                                                                                                                                                                                     |                    |
| AREA                                                                                                                                                                  | P/AREA     | DOC. CODE      | SERIAL No. | REV.                                                                                                                                                                                                      | SHT OF SHT         |

COPYRIGHT © 2020 ALL RIGHTS RESERVED. THIS DOCUMENT IS ISSUED IN ACCORDANCE WITH AN AGREEMENT BETWEEN ROBT STONE AND IT'S CLIENTS, WHICH SETS OUT THE ENTIRE RIGHTS, OBLIGATIONS AND LIABILITIES OF THE PARTIES WITH RESPECT TO THE CONTENT AND USE OF THIS DOCUMENT.  
FILE PATHWAY: X:\9.0 Engineering\9.5 Electrical\9.5.2 Elec. Dwg's\01. Pkg.1 - P30255\03. EarthL\Shoh\P30255-29-01-59-1632 - EL Sec-7A CDS\Rev. A\04. Native File\P30255-29-01-59-1632-14.dwg

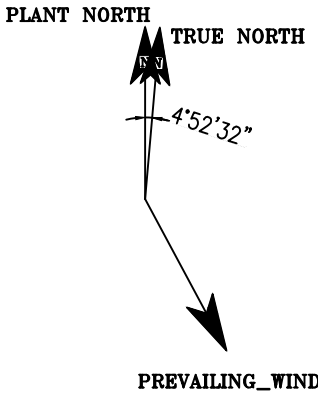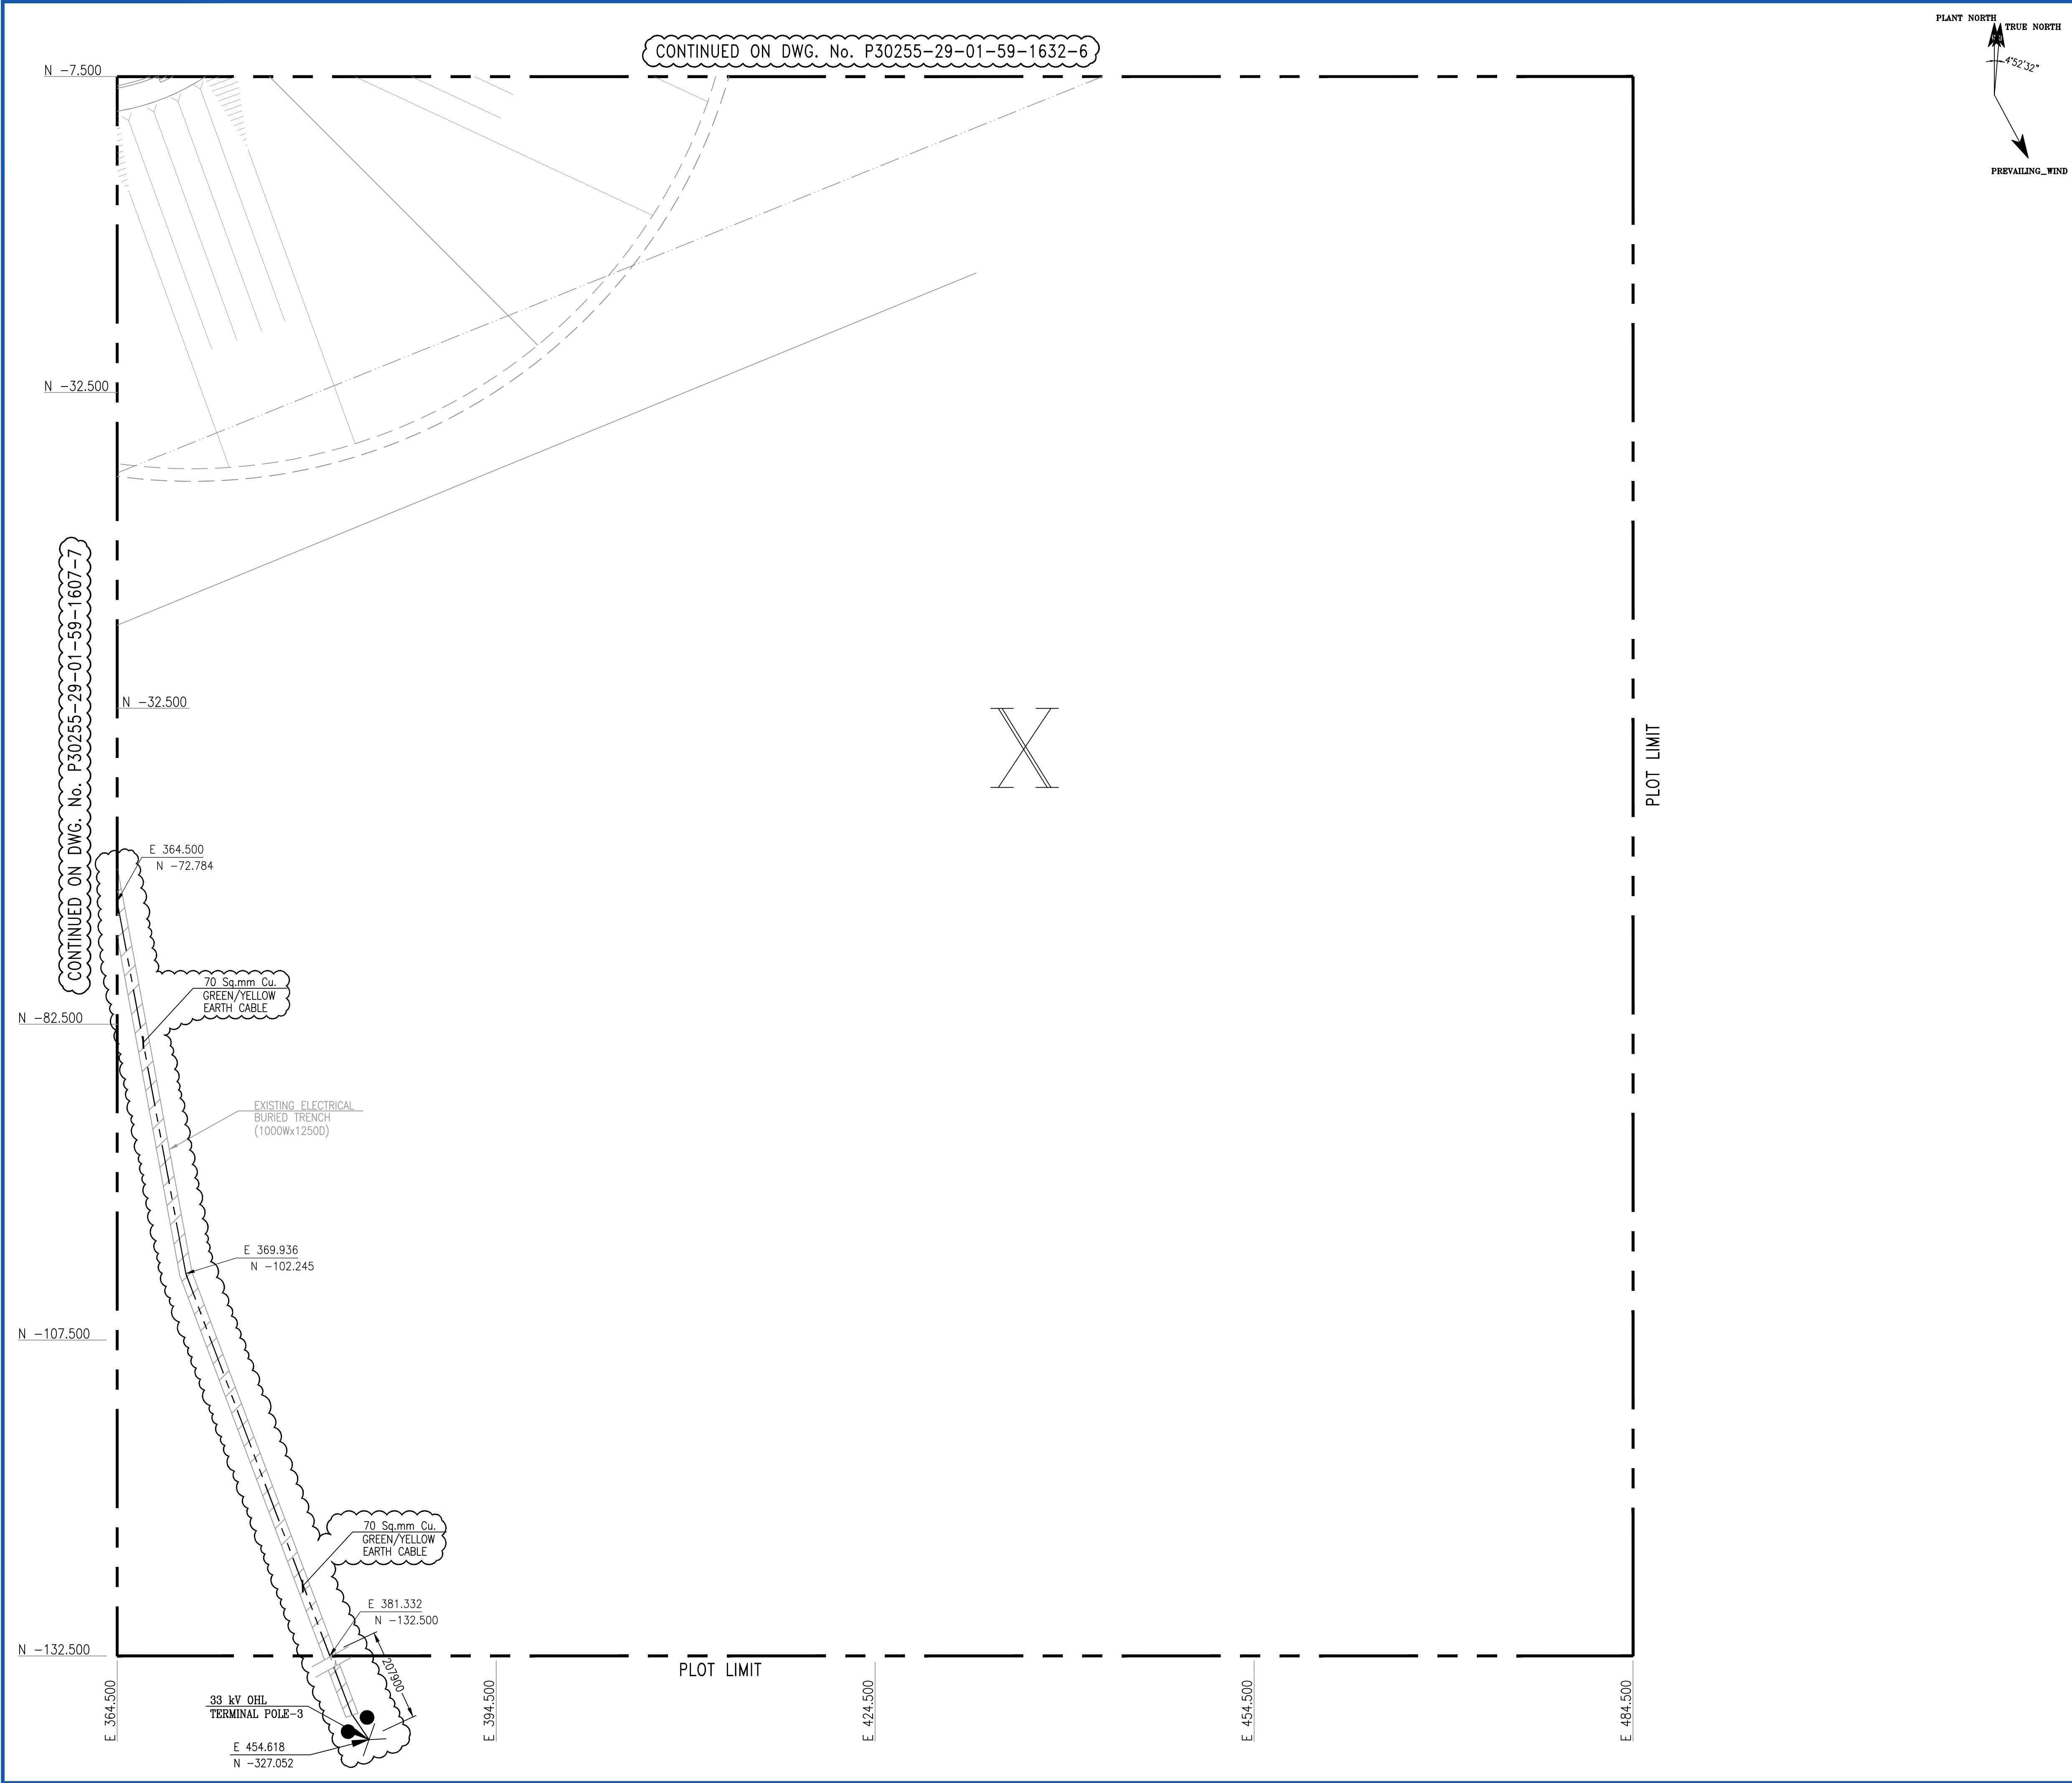

- NOTES
- 1. ALL DIMENSIONS ARE IN MILLIMETERS AND CO-ORDINATES ARE IN METERS UNLESS OTHERWISE NOTED.
  - 2. FOR GENERAL NOTES, LEGENDS & REFERENCE DRAWINGS REFER SHEET 1 OF THIS DRAWING.

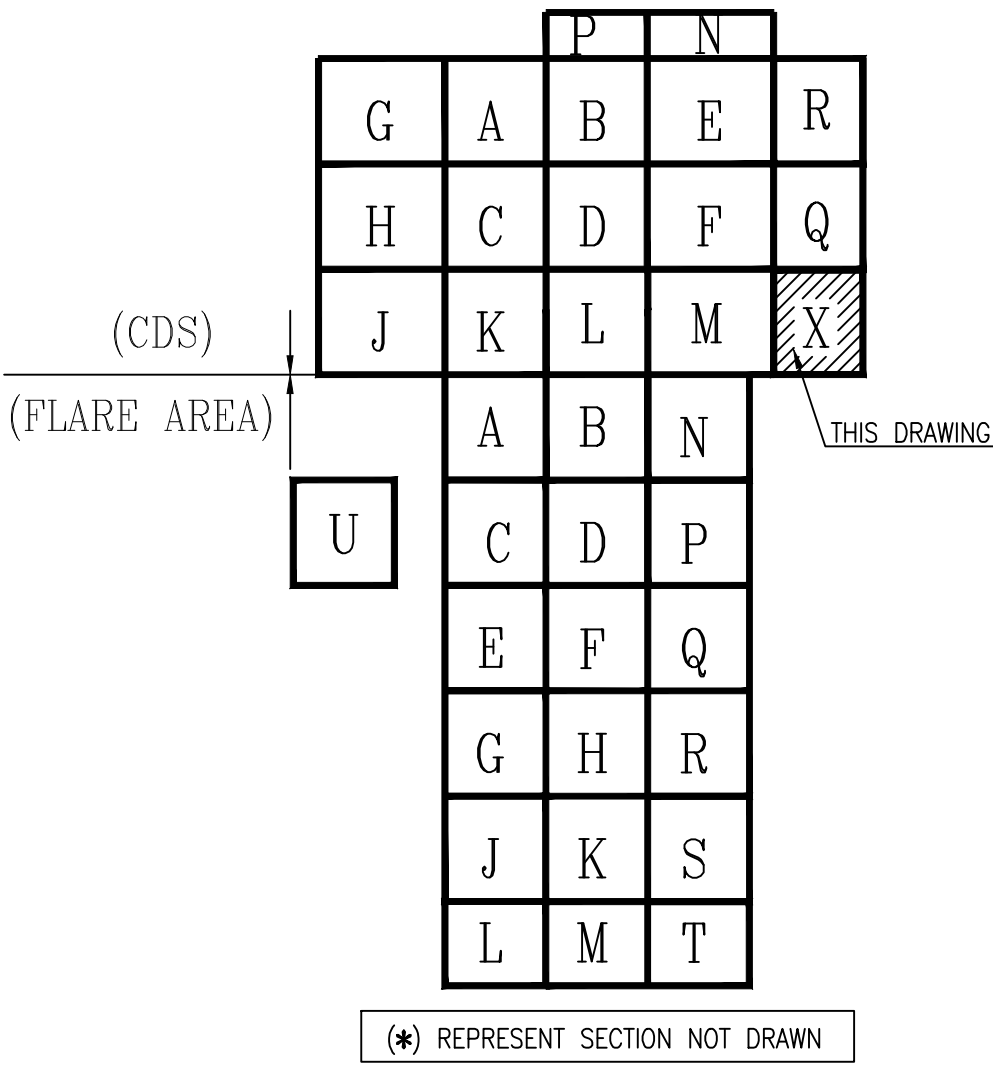

CLOUDED PORTION DENOTES :  
THE SCOPE OF WORK UNDER THE PROJECT NO. P30255

|              |            |                |       |                    |                   |
|--------------|------------|----------------|-------|--------------------|-------------------|
|              |            |                |       |                    |                   |
| A            | 28/11/2025 | JS             | SG    | RPK                | ISSUED FOR REVIEW |
| REV.         | DATE       | DR'N.          | CH'D. | AP'D.              | DESCRIPTION       |
| SCALE: 1:250 |            | LOCATION: SHAH |       | PROJECT No. P30255 |                   |



أدنوك البرية  
**ADNOC Onshore**

CONSULTANT / CONTRACTOR / VENDOR



ROBT STONE (ME) LLC  
P.O. Box 39588  
Abu Dhabi, UAE

DRAWING No.

PROJECT: REPLACEMENT OF AGED ELECTRICAL EQUIPMENT  
AT SE FIELD

DRG. TITLE:  
**EXTERNAL ELECTRICAL EARTHING LAYOUT**  
**33kV SUBSTATION (INSTALLATION)**  
SHAH : CDS

DRG.No. **2901591632** A 14/14

AREA P/AREA DOC. CODE SERIAL No. REV. SHT OF SHT