
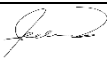


|                                                                                  |                                                      |                      |                                                                                                                           |                                                                                                                                                                                                                                                                                          |
|----------------------------------------------------------------------------------|------------------------------------------------------|----------------------|---------------------------------------------------------------------------------------------------------------------------|------------------------------------------------------------------------------------------------------------------------------------------------------------------------------------------------------------------------------------------------------------------------------------------|
|  | <b>EPC FOR UPGRADATION OF FACILITIES AT SE FIELD</b> |                      |                                                                                                                           |                                                                                                                                                                                                       |
|                                                                                  | <b>COMMENTS RESOLUTION SHEET (CRS)</b>               |                      |                                                                                                                           |                                                                                                                                                                                                                                                                                          |
| Contract No.                                                                     | 4700022908                                           | Project No.          | P30377                                                                                                                    | Comment Code -2                                                                                                                                                                                                                                                                          |
| Document No.                                                                     |                                                      | Transmittal No.      | Document Title                                                                                                            | <input type="checkbox"/> 1 Approved – No Comments<br><input checked="" type="checkbox"/> 2 Approved Subject to Incorporation of Comments<br><input type="checkbox"/> 3 Revise and Resubmit<br><input type="checkbox"/> 4 Rejected<br><input type="checkbox"/> 5 Retained for Information |
| P29171-29-01-08-1601                                                             | C                                                    | ATC-4700022908-00770 | <b>PIPING AND INSTRUMENT DIAGRAM</b><br><b>DISPOSAL WATER: P-2415, 2416 &amp; 2417</b><br><b>CDS: SHAH (CONSTRUCTION)</b> |                                                                                                                                                                                                                                                                                          |

| S. No. | Reference / Page No. | COMPANY Comments                                                                                 | CONTRACTOR Response                                                                    | Status / Remarks                                                                      |
|--------|----------------------|--------------------------------------------------------------------------------------------------|----------------------------------------------------------------------------------------|---------------------------------------------------------------------------------------|
|        |                      | <b>PROCESS DISCIPLINE</b>                                                                        |                                                                                        |                                                                                       |
| 1.     | P29171-29-01-08-1601 | Add the note on the P&ID for reference.                                                          | Note-12 has been incorporated as per existing site conditions.                         |                                                                                       |
| 2.     | P29171-29-01-08-1601 | Blind flange size to be confirmed.                                                               | Blind Size has been confirmed for all the flanges in Note-13 and Note-14 respectively. |                                                                                       |
|        |                      | <b>DESIGN REVIEW</b>                                                                             |                                                                                        |                                                                                       |
| 3.     | P29171-29-01-08-1601 | Spec Breaks at flanges to indicate the blind flange material considering clarity for future use. | Note 15 and Note 16 are incorporated accordingly to confirm the Blind Flange material. |                                                                                       |
|        |                      | ORIGINATOR                                                                                       | REVIEWED BY                                                                            | APPROVED BY                                                                           |
| Name   |                      | Shehzad Ajmal                                                                                    | Muhammad Uzair Yaseen                                                                  | Anantha Kumar Rajamani                                                                |
| Sign   |                      |               |   |  |
| Date   |                      | 4-Oct-2024                                                                                       | 4-Oct-2024                                                                             | 4-Oct-2024                                                                            |

COPYRIGHT © 2020 ALL RIGHTS RESERVED. THIS DOCUMENT IS ISSUED IN ACCORDANCE WITH AN AGREEMENT BETWEEN ROBS STONE AND ITS CLIENTS, WHICH SETS OUT THE ENTIRE RIGHTS, OBLIGATIONS AND LIABILITIES OF THE PARTIES WITH RESPECT TO THE CONTENT AND USE OF THIS DOCUMENT.  
FILE PATHWAY: M:\9.0 Engineering\9.2 Process Drawings\9.2.2.4 P&ID Construction\9.2.2.4.3 Rev. D\29171-29-01-08-1601.dwg

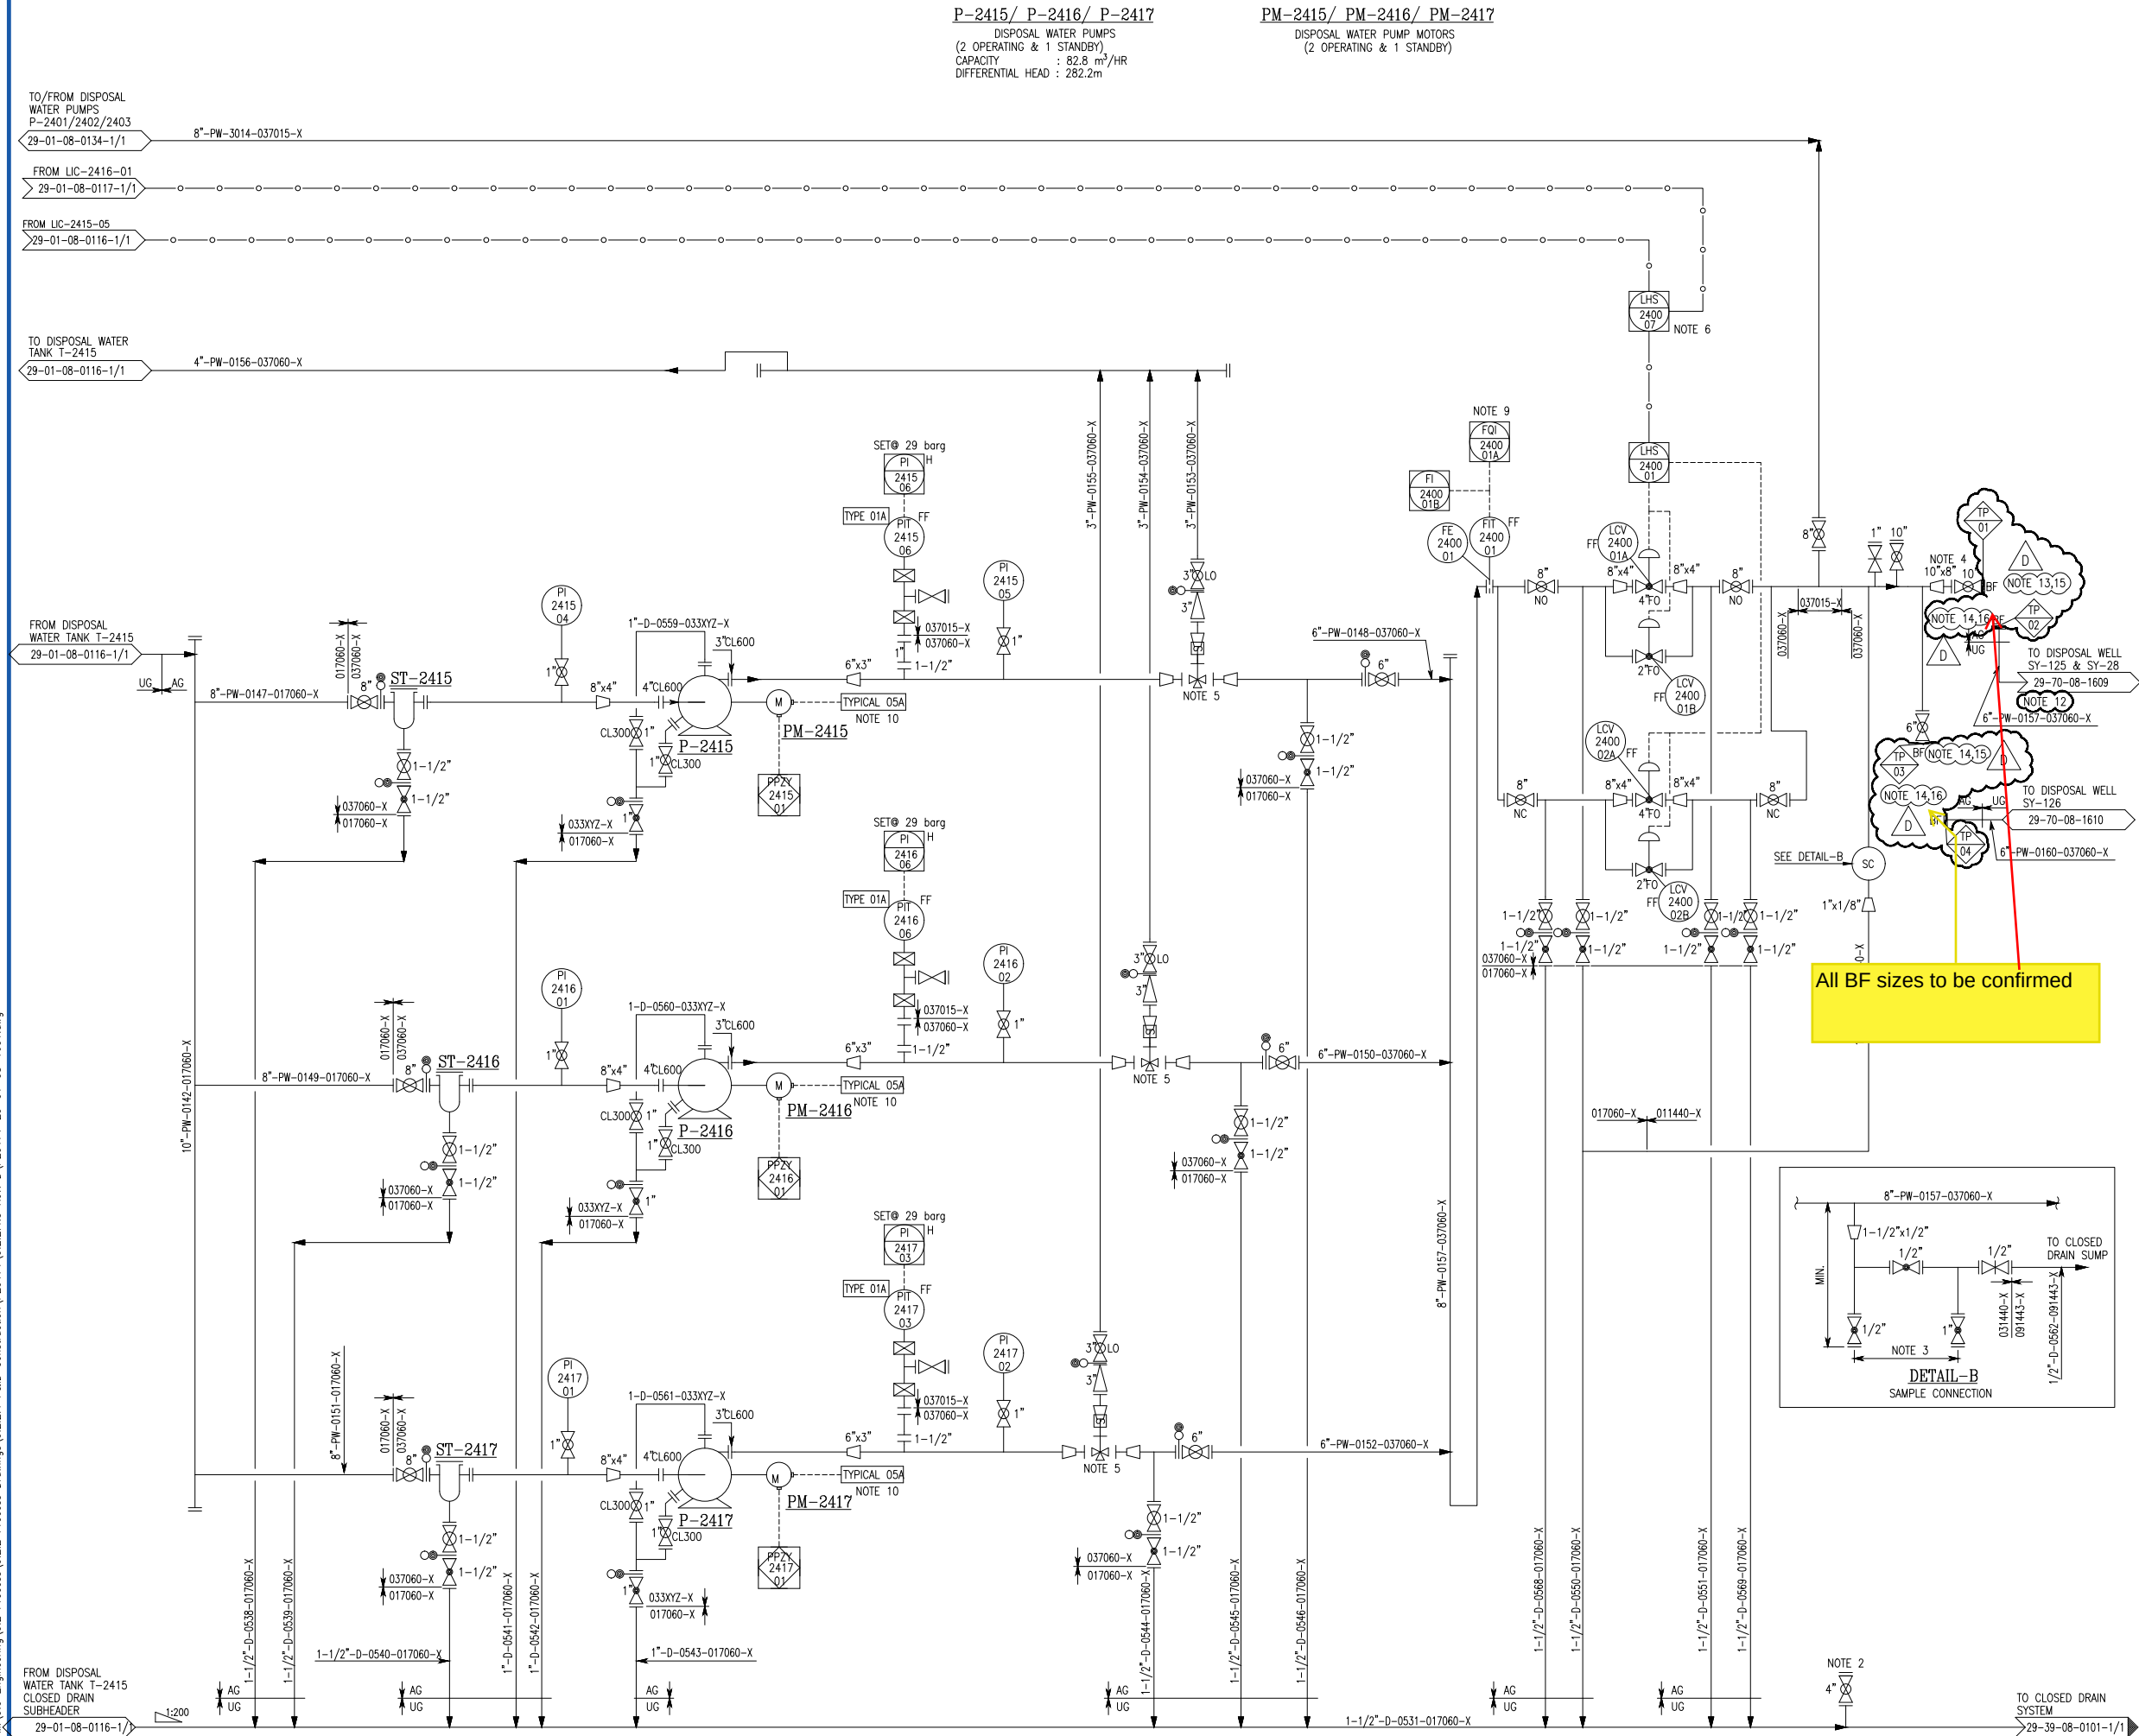

- ### NOTES
- ALL EQUIPMENT AND INSTRUMENT TAG NUMBERS ON THIS DRAWING ARE PREFIXED BY AREA CODE (29) AND PLANT AREA CODE (01) UNLESS SPECIFIED OTHERWISE.
  - FOR CONNECTION FROM FUTURE DISPOSAL PUMPS.
  - SPACE ALLOTTED FOR SAMPLE PUMP.
  - PROVISION FOR OIL IN WATER CONTINUOUS MEASUREMENT. CONNECTION IS PROVIDED FROM THE TOP.
  - MODULATING VALVE (AUTO-RECIRCULATION TYPE WITH INBUILD CHECK VALVE) IS LOCATED MINIMUM DISTANCE FROM PUMPS P-2415/P-2416/P-2417.
  - T-2415 AND T-2416 ARE NORMALLY BOTH IN USE AND BALANCED. IN THIS SITUATION EITHER LIC-2415-05 OR LIC-2416-01 IS SELECTED TO SEND SIGNAL TO LCV-2400-01/02. IF ONE TANK IS TAKEN OUT OF DUTY THEN THE LIC ASSOCIATED WITH THE IN DUTY TANK IS SELECTED.
  - ALL LOCAL PANEL INSTRUMENTS ARE LOCATED IN EWDF/EWTP CONTROL ROOM PANEL.
  - THIS LINE IS USED TO REVERSE FLOW CDS EFFLUENT WATER, THROUGH RDS-2-RDS-1-CDS WATER TRANSFER LINE, TO THE RDS-1 DISPOSAL WELL.
  - THIS INDICATION IS TRANSMITTED THROUGH SCADA TO MTU AT SHAH-1.
  - FOR DETAILS REFER TO P&ID NO. 30-99-08-0123 SHT. 3/4.
  - FOR DEMOLITION SCOPE, REFER P&ID NO. P29171-29-01-08-1615-1.
  - LINE SIZE IS 6 INCHES AS PER EXISTING SITE CONDITIONS.
  - BLIND FLANGE SIZE SHALL BE 10 INCH AS PER THE LINE SIZE.
  - BLIND FLANGE SIZE SHALL BE 6 INCH AS PER THE LINE SIZE.
  - THE BLIND FLANGE MATERIAL SHALL BE CARBON STEEL, SAME AS THE VALVE, AS PER THE SITE CONDITION.
  - THE BLIND FLANGE MATERIAL SHALL BE CARBON STEEL AS THE PIPING IS BEING ABANDONED.

### LEGEND

|  |                |
|--|----------------|
|  | SCOPE CLOUD    |
|  | REVISION CLOUD |
|  |                |

### REFERENCE DRAWINGS

| TITLE                                                                                | DRG.No.       |
|--------------------------------------------------------------------------------------|---------------|
| P&ID LEGEND                                                                          | 29-99-08-001  |
| P&ID DISPOSAL WELL No. 1 SHAH-1                                                      | 29-70-08-0102 |
| P&ID DISPOSAL WATER TANK T-2415 SHAH CDS                                             | 29-01-08-0116 |
| P&ID- DISPOSAL WATER PUMPS P-2401/P-2402 /P-2403 - SHAH CDS                          | 29-01-08-0134 |
| P&ID DISPOSAL WATER TANK T-2416 SHAH CDS                                             | 29-01-08-0117 |
| P&ID - FLARE & BURN PIT                                                              | 29-39-08-0101 |
| P&ID DISPOSAL WELL No. SY-125 & SY-028 CDS : SHAH (DEMOLITION)                       | 29-70-08-1615 |
| PIPING AND INSTRUMENT DIAGRAM DISPOSAL WELL NO SY-125 & SY 155 SHAH-1 (CONSTRUCTION) | 29-70-08-1609 |
| P&ID DISPOSAL WELL No. SY-126 SHAH-1 (DEMOLITION)                                    | 29-70-08-1616 |
| PIPING AND INSTRUMENT DIAGRAM WATER DISPOSAL WELL SY-126 SHAH-1                      | 29-70-08-1607 |

THIS DRAWING DEVELOPED FROM ADNOC ONSHORE PROJECT (P29171) DWG. NO. 29-70-08-0601, SHT. 1 OF 1, REV.1

CLOUDED PORTION DENOTES :  
THE SCOPE OF WORK UNDER THE PROJECT P29171

|            |            |                |       |                    |                        |
|------------|------------|----------------|-------|--------------------|------------------------|
| D          | 04/10/2024 | SV             | MUY   | AKR                | ISSUED FOR HAZOP       |
| C          | 05/09/2024 | SV             | MUY   | AKR                | RE-ISSUED FOR APPROVAL |
| B          | 03/08/2024 | SV             | NKP   | TE                 | ISSUED FOR APPROVAL    |
| A          | 24/05/2024 | SV             | NKP   | TE                 | ISSUED FOR REVIEW      |
| REV.       | DATE       | DR'N.          | CH'D. | AP'D.              | DESCRIPTION            |
| SCALE: NTS |            | LOCATION: SHAH |       | PROJECT No. P29171 |                        |

**أدنوك البرية**  
**ADNOC Onshore**

CONSULTANT / CONTRACTOR / **ROB STONE (ME) LLC**

DRAWING No. \_\_\_\_\_

PROJECT: REPLACEMENT OF WATER DISPOSAL GRE LINES AT SHAH

DRG. TITLE:  
**PIPING AND INSTRUMENT DIAGRAM  
DISPOSAL WATER : P-2415, 2416 & 2417  
CDS : SHAH (CONSTRUCTION)**

|         |            |           |            |
|---------|------------|-----------|------------|
| DRG.No. | 2901081601 | D         | 1/1        |
| AREA    | P/AREA     | DOC. CODE | SERIAL No. |
| REV.    | SHT        | OF        | SHT        |